


SECTION 30

#5349- Saddle Waterhole #3

NW SW

TOWNSHIP 28 S, RANGE 37 E, W. M.

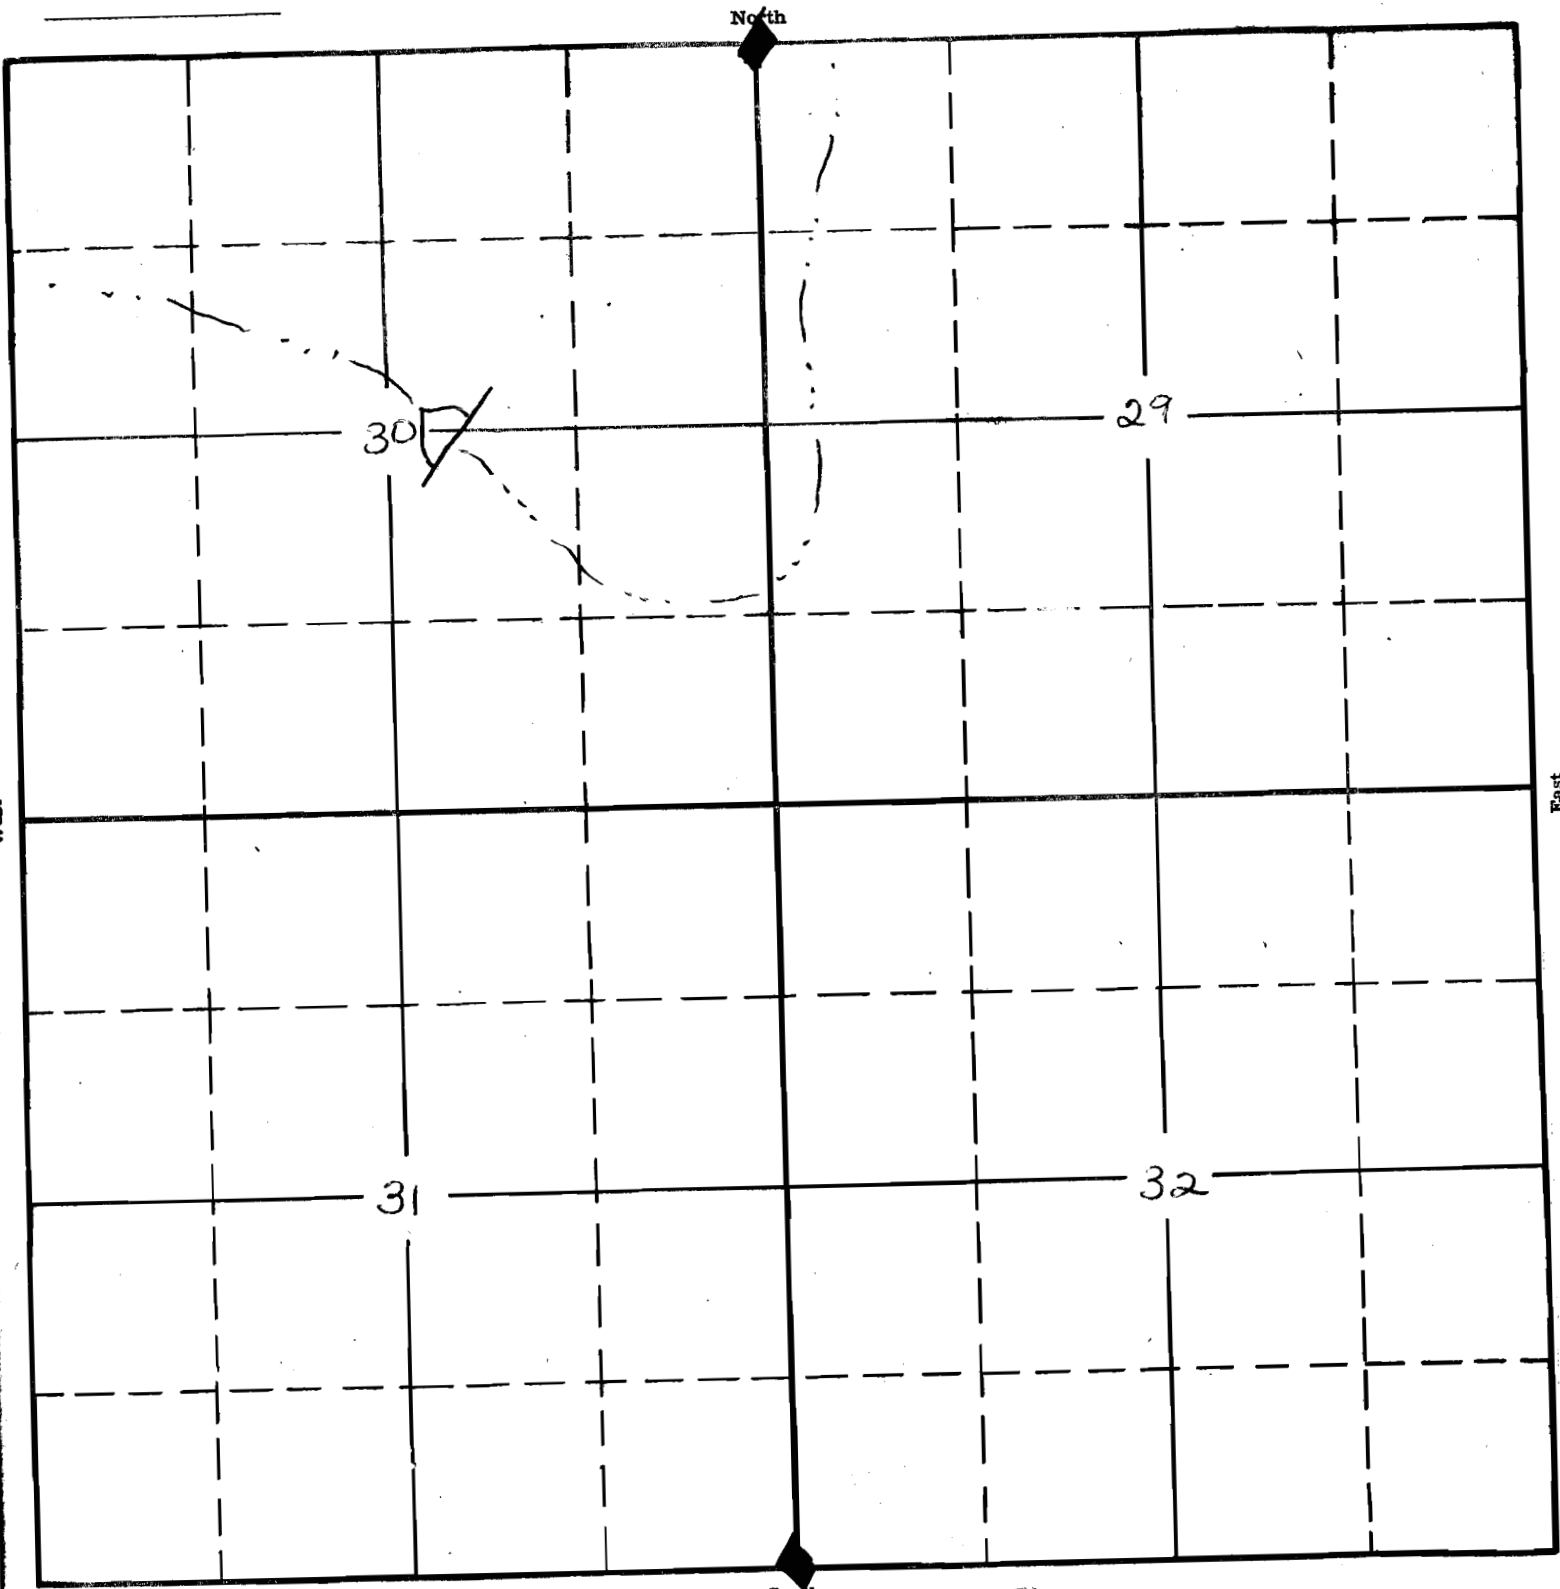

Application No. R66509
Permit No. R10272

SEP 11 1983
LAND RESOURCES DEPT.
SALEM, OREGON

APPLICATION No.
PERMIT No.