


SECTION 30  
NW 52  
\_\_\_\_\_  
\_\_\_\_\_  
\_\_\_\_\_

# 5348 - Saddle Waterhole #2

TOWNSHIP 28 S, RANGE 37 E, W. M.

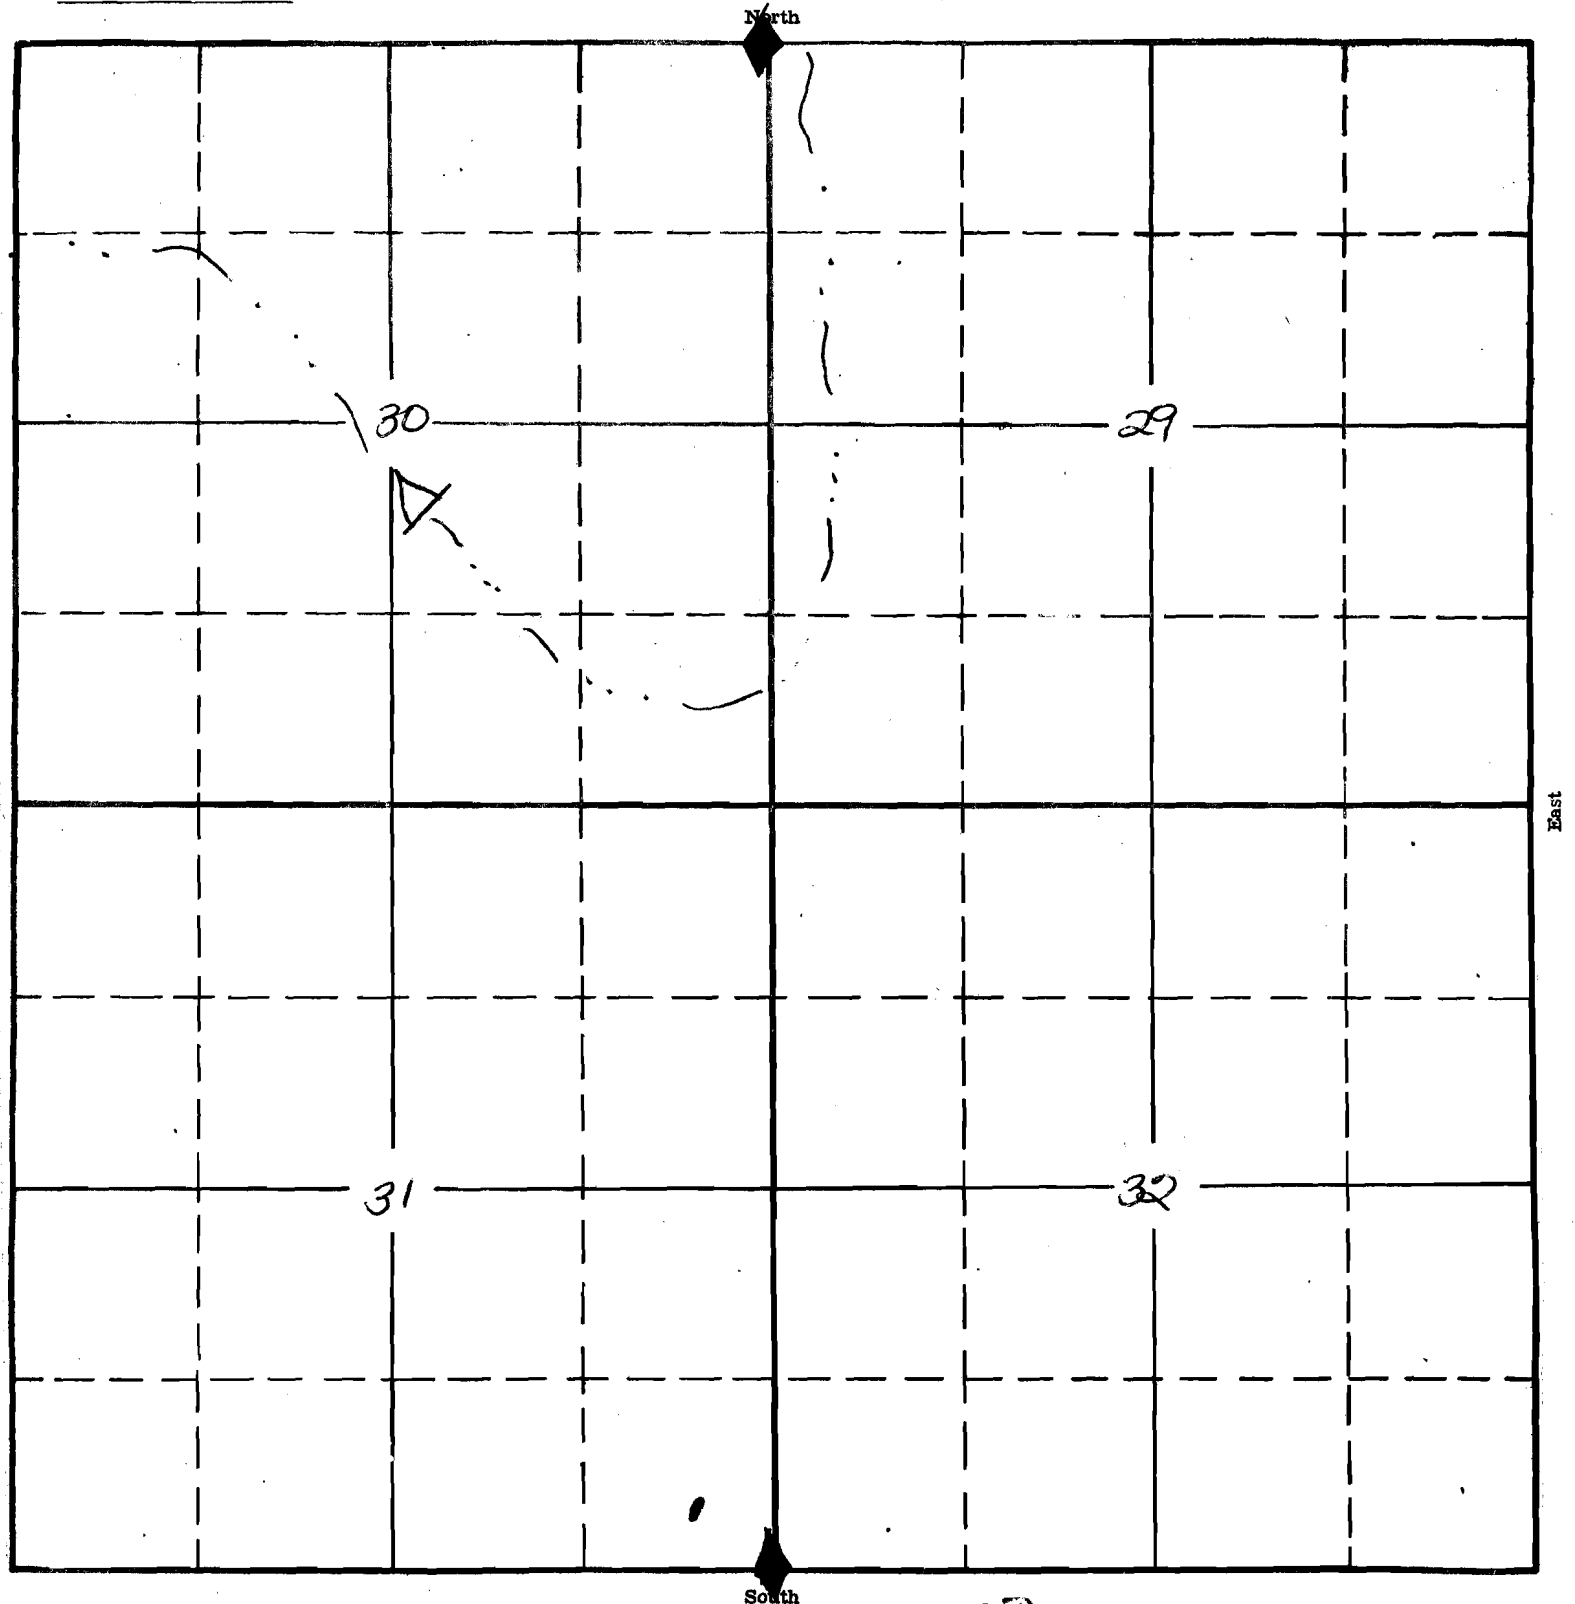

Application No. R66510  
Permit No. R10273

SEP 2 1983  
LAND RESOURCES DEPT.  
SALEM, OREGON

APPLICATION No.  
PERMIT No.