

SECTION


19 NWSE

R-10327

TOWNSHIP 14S, RANGE 27E, W. M.

Aldrich Gulch 7.5' Quad

North Jackass Mtn Res. #4831

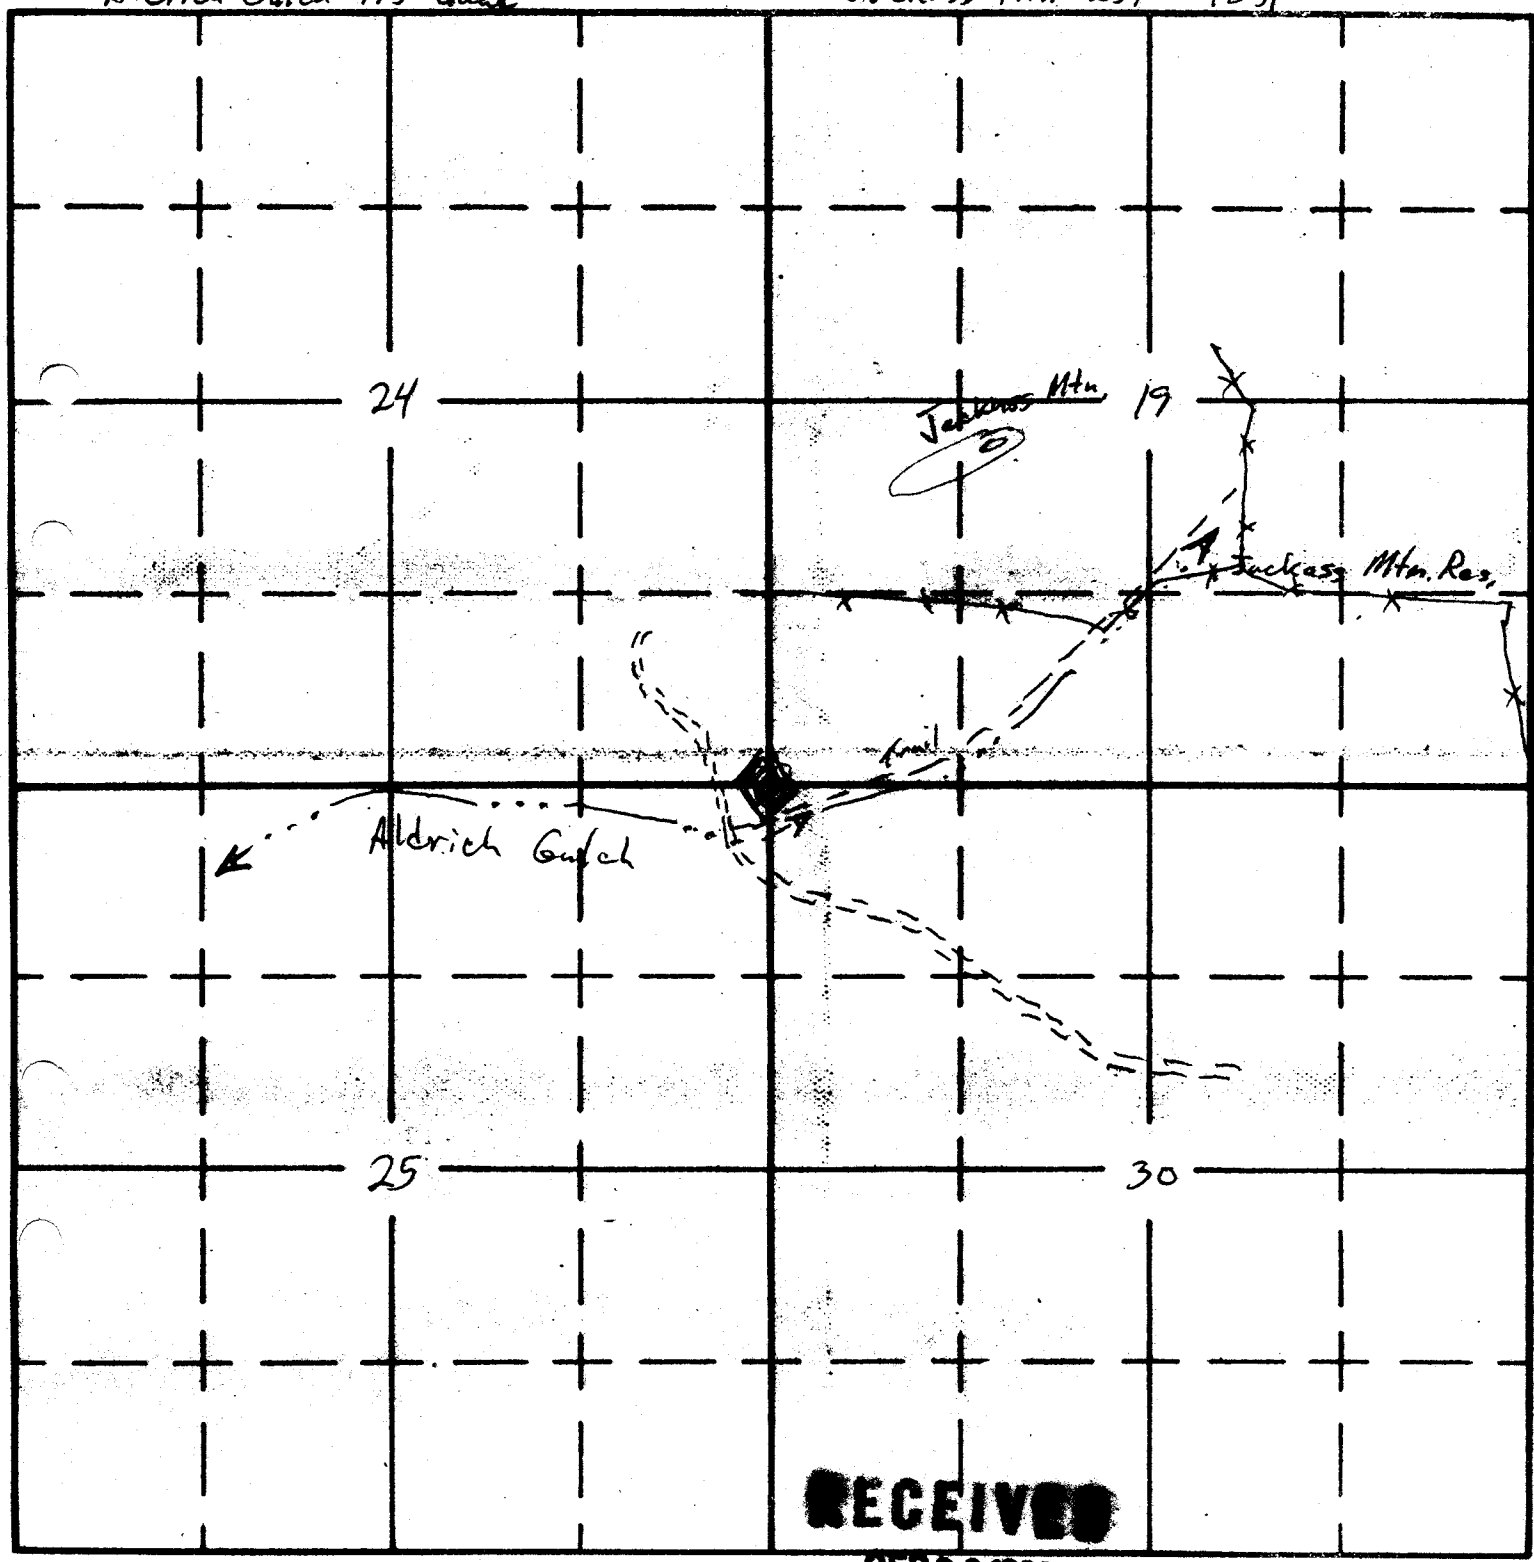

RECEIVED

South

SEP 30 1983

WATER RESOURCES DEPT.
SALAS, OREGON

Application No. R 00007

Permit No. R10327