

SECTION

10


NW SW

09-4824

ELLIOT RES.

TOWNSHIP 31 S, RANGE 32 ³/₄ E, W. M.

North

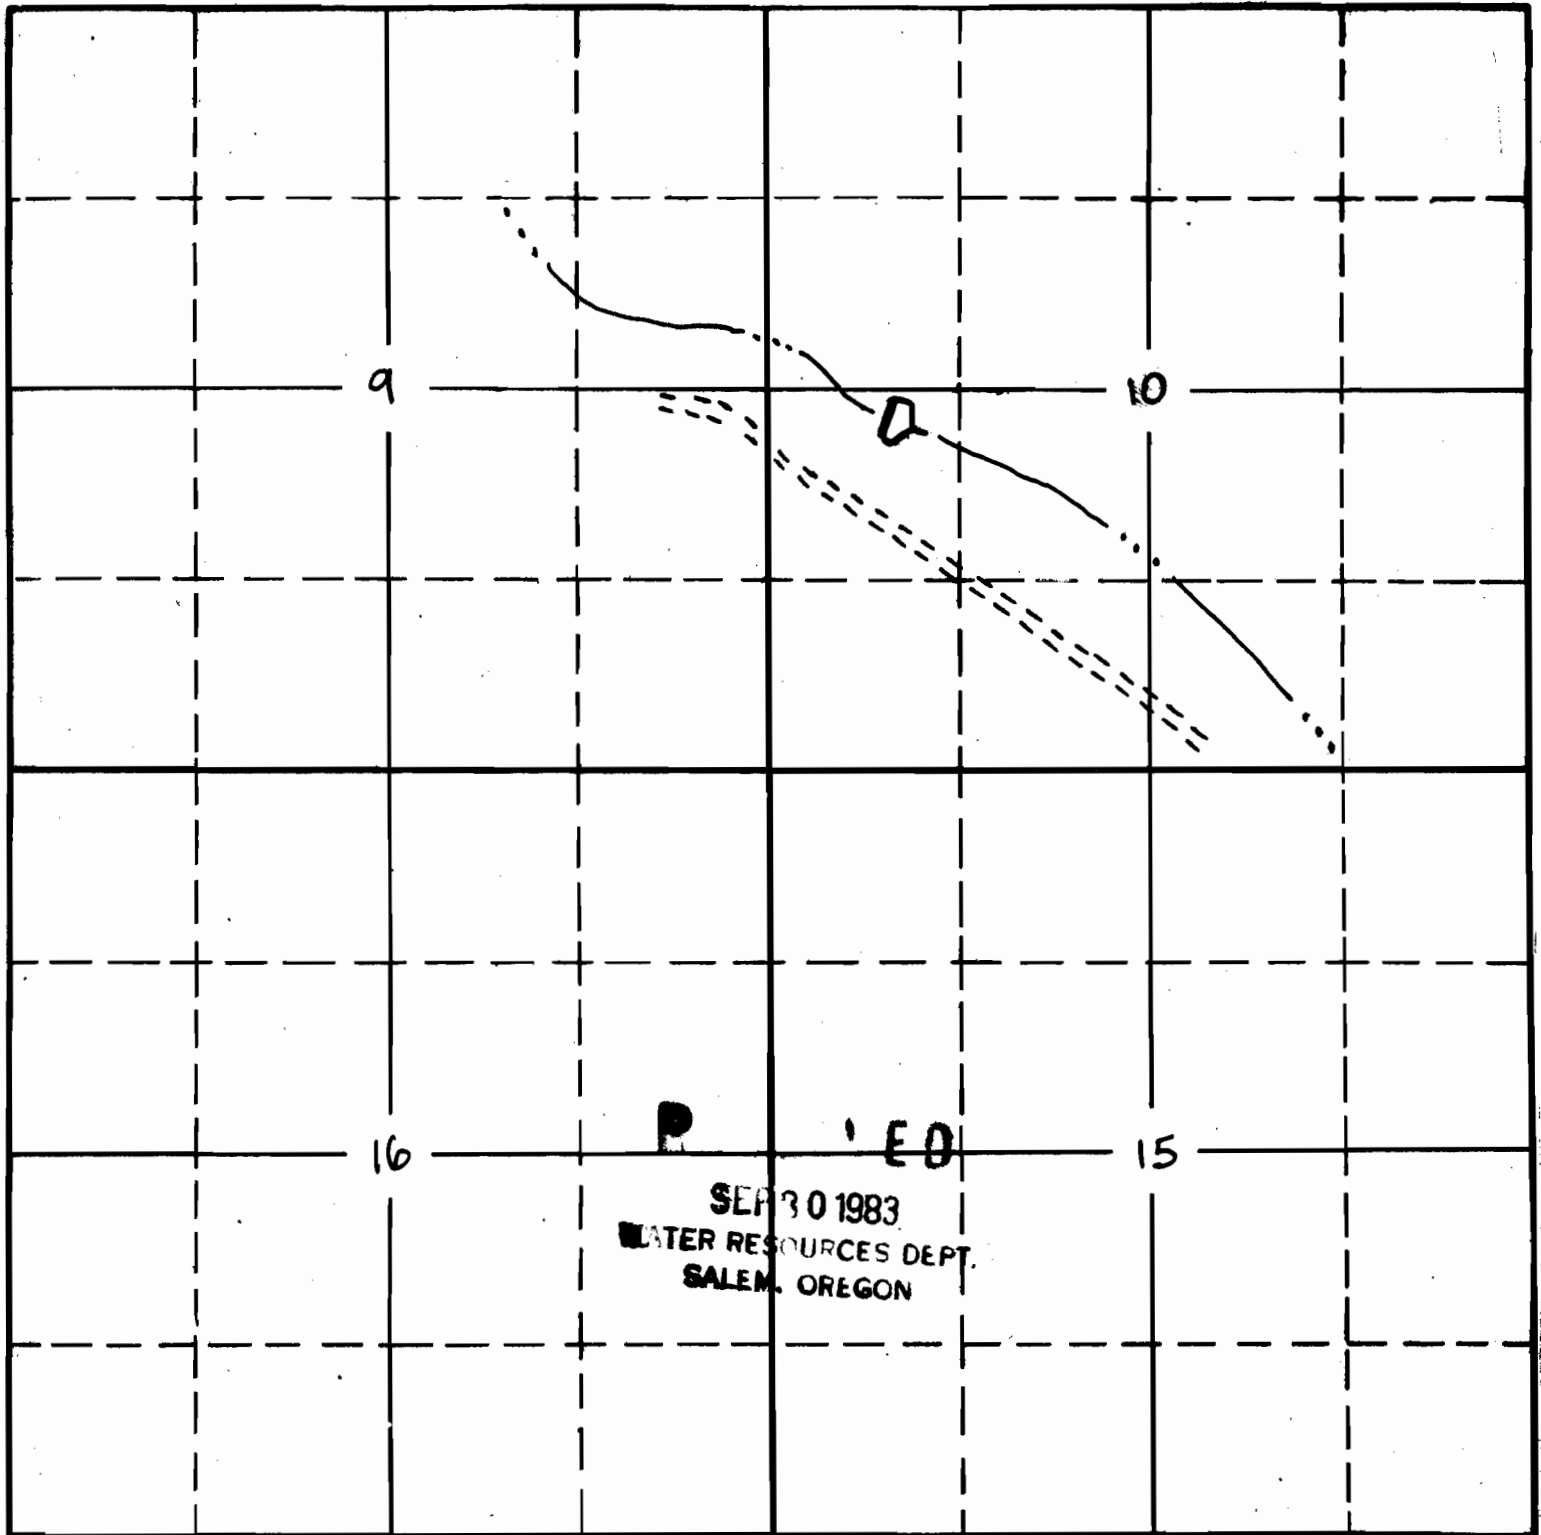

South

APPLICATION No.

R-67018

PERMIT No.

R10316