


SECTION 33
SW SW

09-4819
LAUSERICA RES. #2

TOWNSHIP 34S, RANGE 32 1/2 E, W. M.

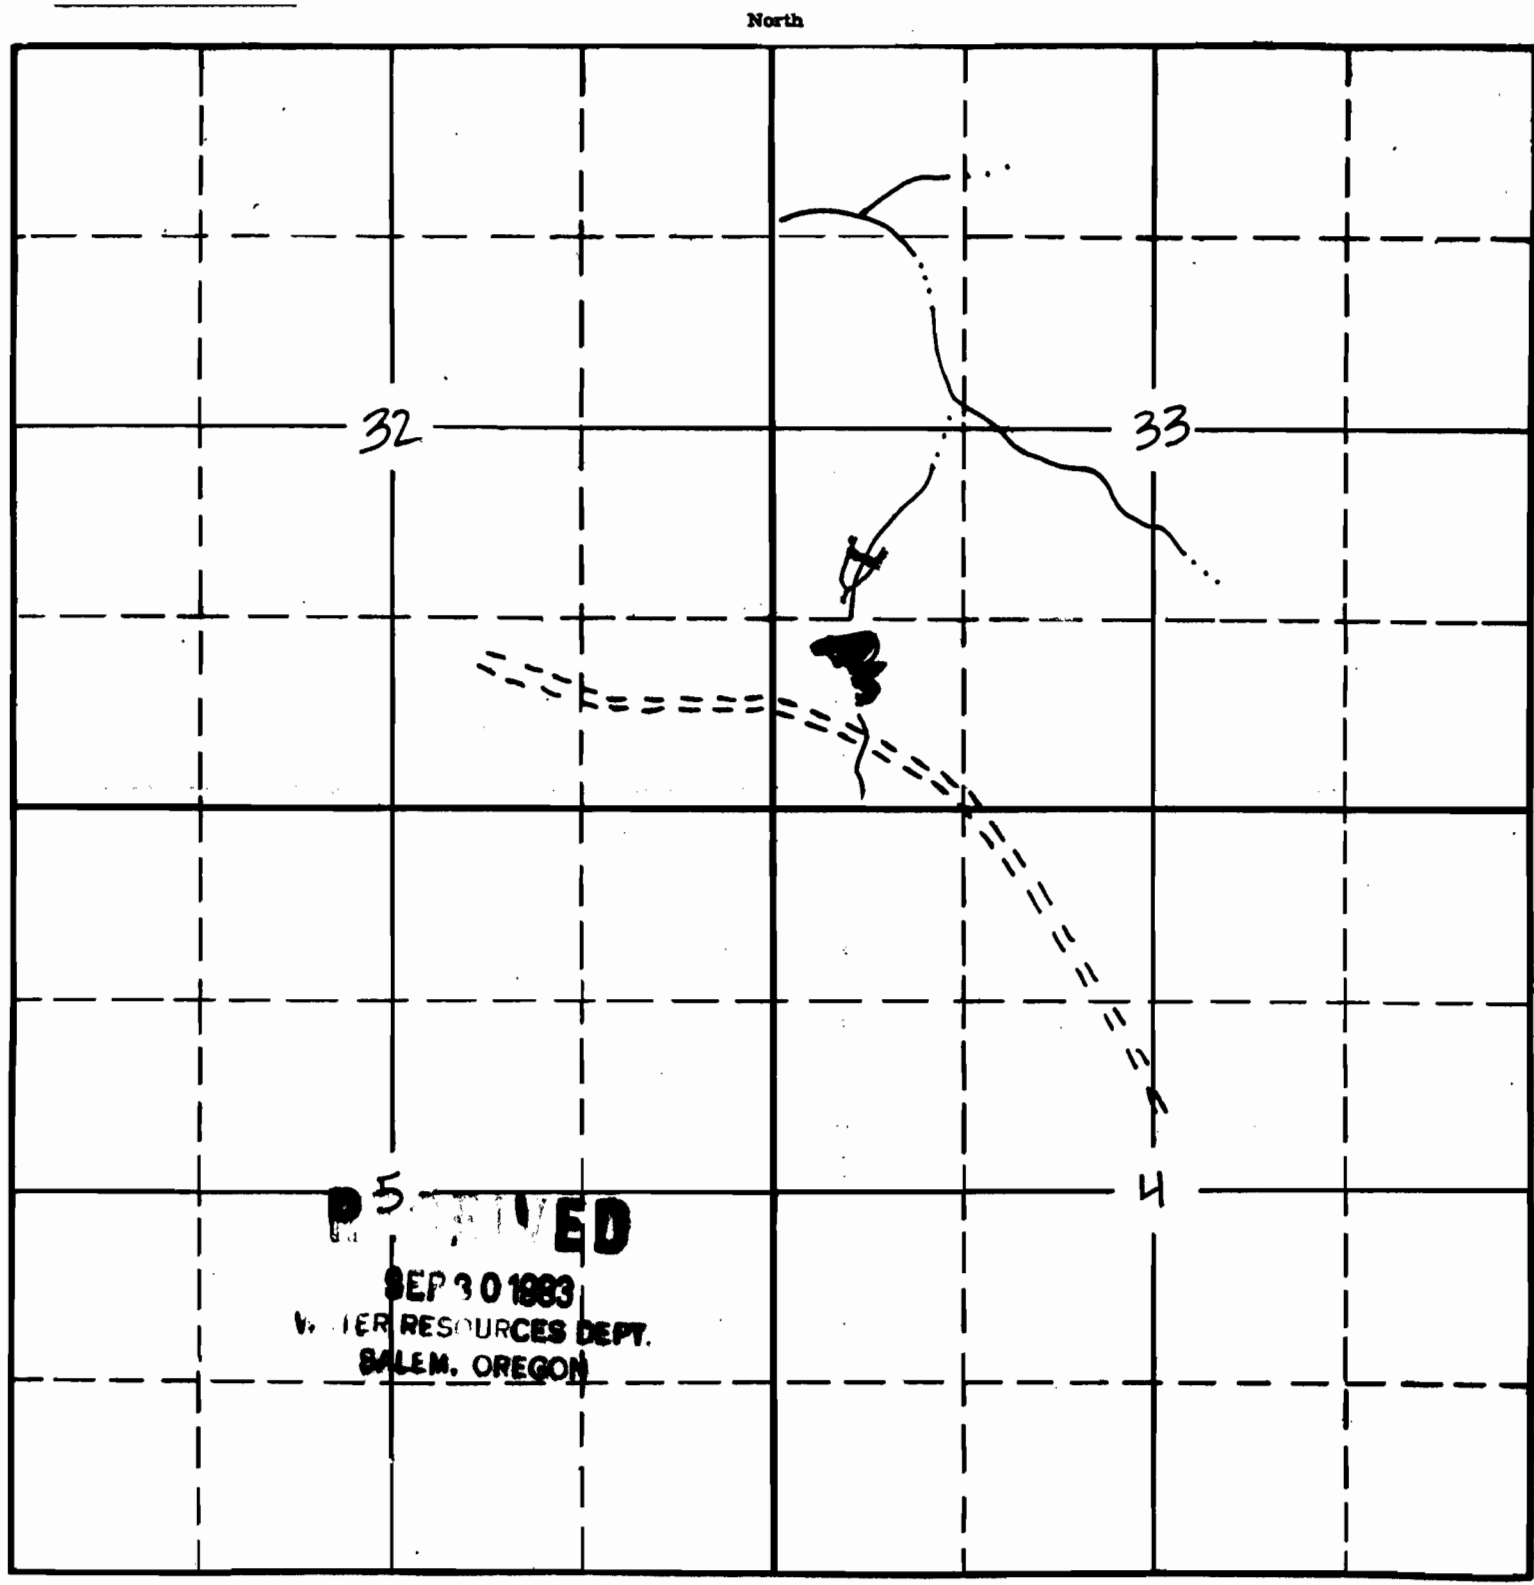

RECEIVED
SEP 30 1983
WATER RESOURCES DEPT.
SALEM, OREGON

2-67027

APPLICATION No.

PERMIT No.

R10354