

SECTION

10


SE NW

09-4770

DRY RES.

TOWNSHIP 35 S, RANGE 32 1/2 E, W. M.

North

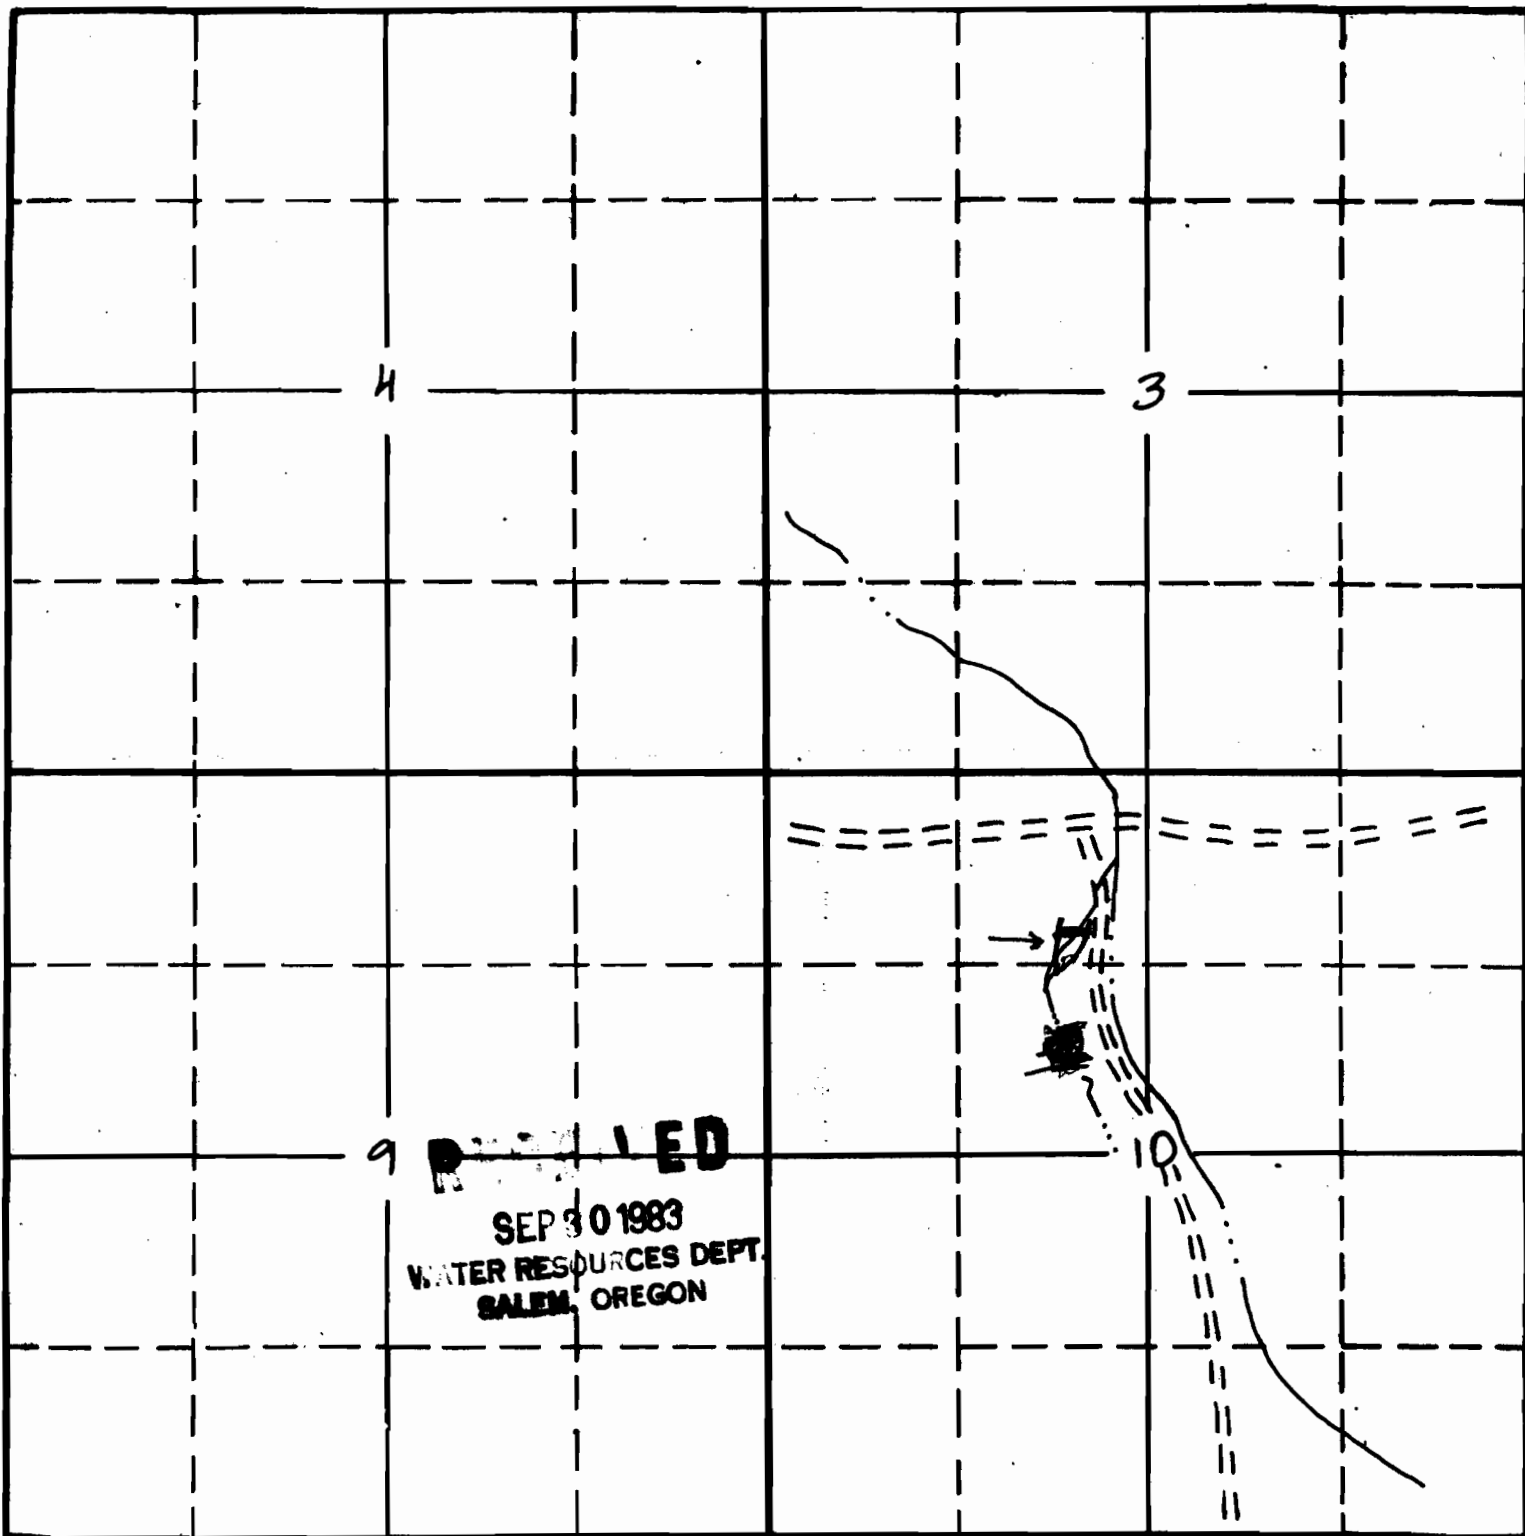

9 RECEIVED

SEP 30 1983
WATER RESOURCES DEPT.
SALEM, OREGON

South

R-67033

APPLICATION No.

PERMIT No.

R10360