

SECTION

6

NW SE


TOWNSHIP 37S, RANGE 34, W. M.

11-4783

Middle Buckbrush

Spring Hole

North

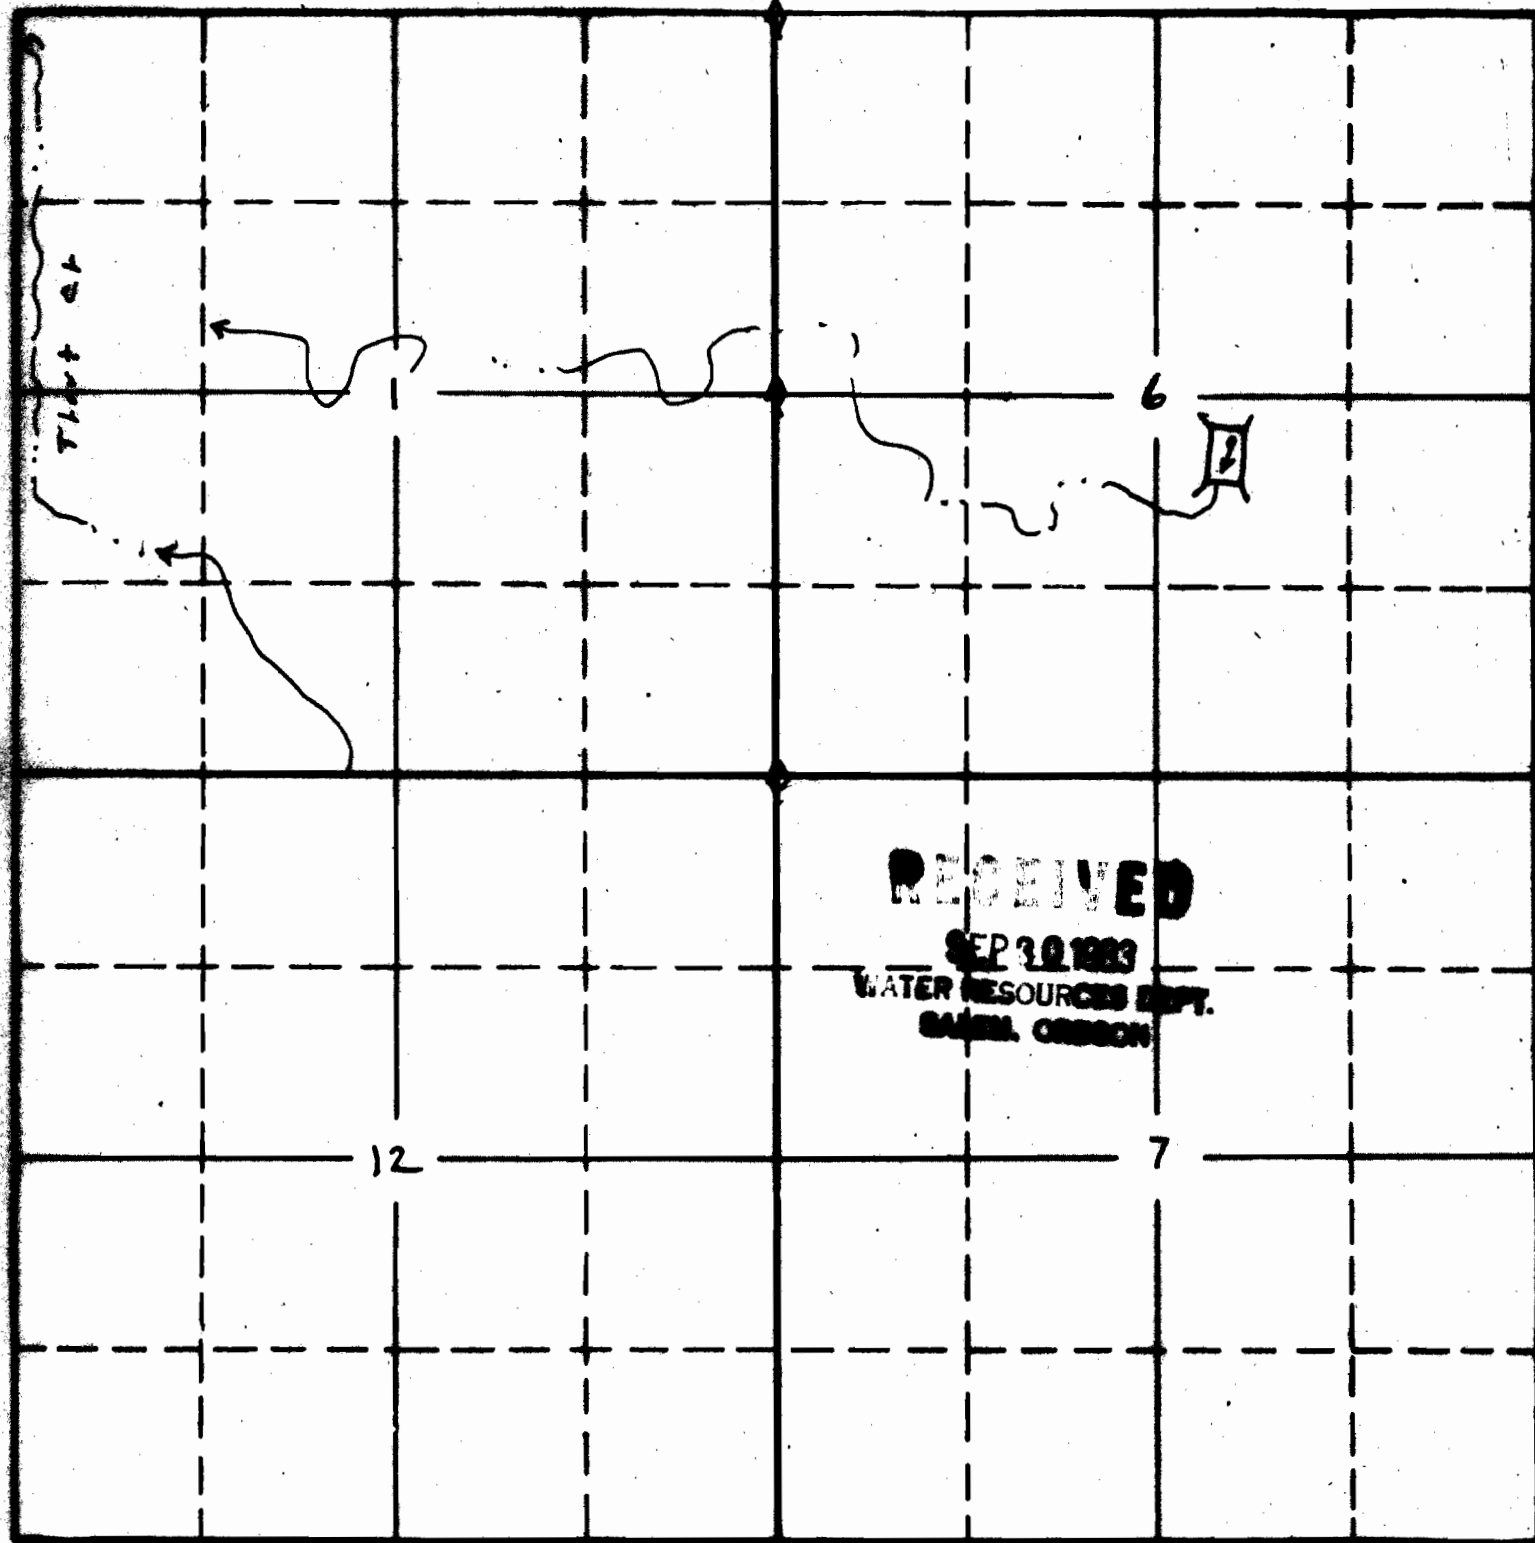

South

R-67044
APPLICATION No.
PERMIT No.
R10370