


SECTION

11- 0155

Mahogany Point Res.

16  
NW SW

TOWNSHIP 38S, RANGE 33E, W. M.

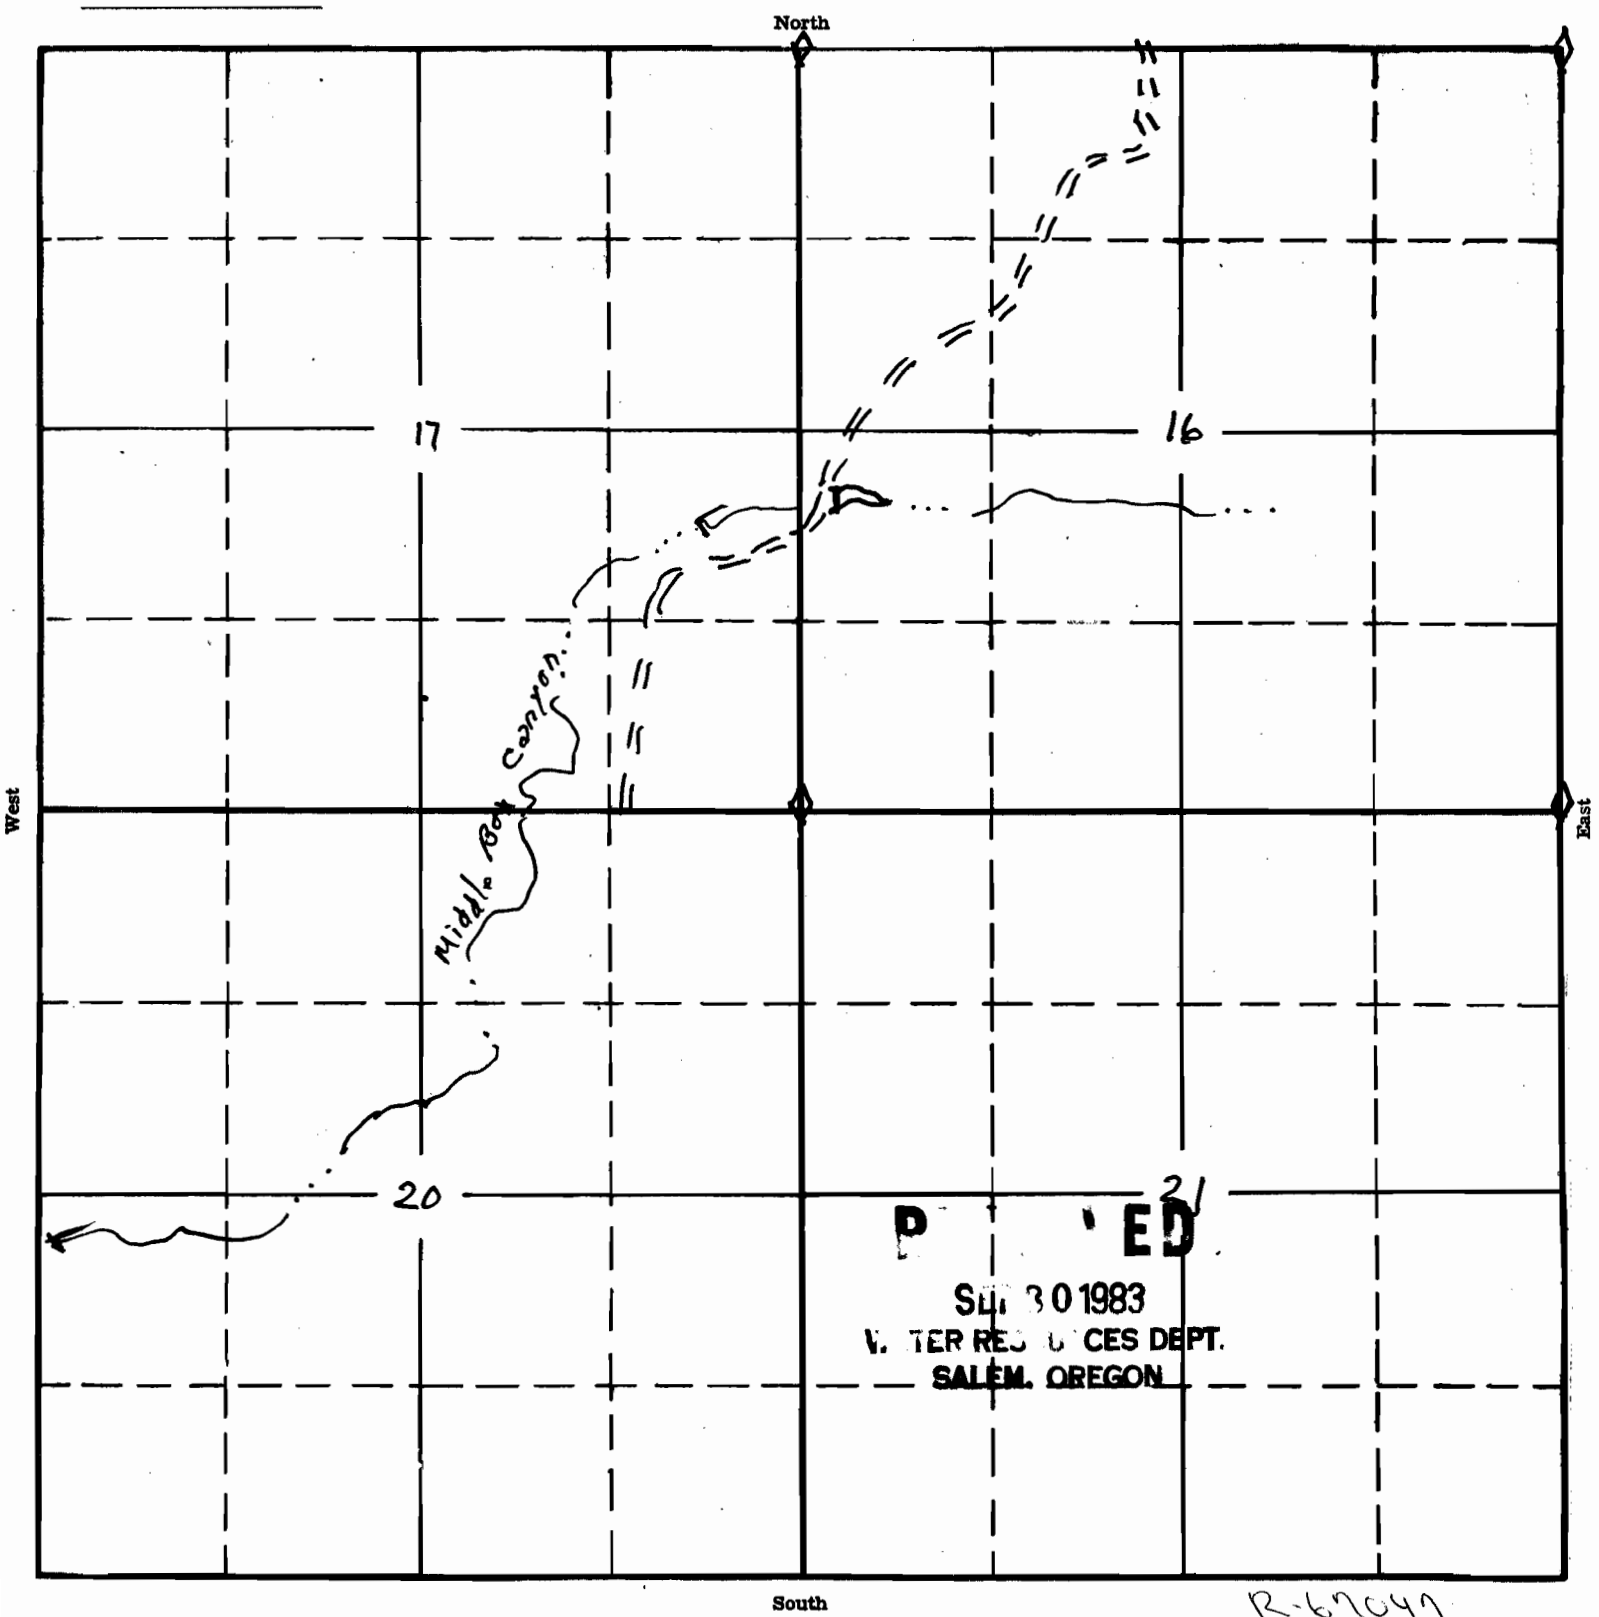

P ED

SEP 30 1983  
WATER RESOURCES DEPT.  
SALEM, OREGON

R-67047

APPLICATION No.

PERMIT No.  
**R10372**