


scale 5.28 inches = 1 mile

T 15 S R 26 E Sec 28 SW 1/4 NE 1/4

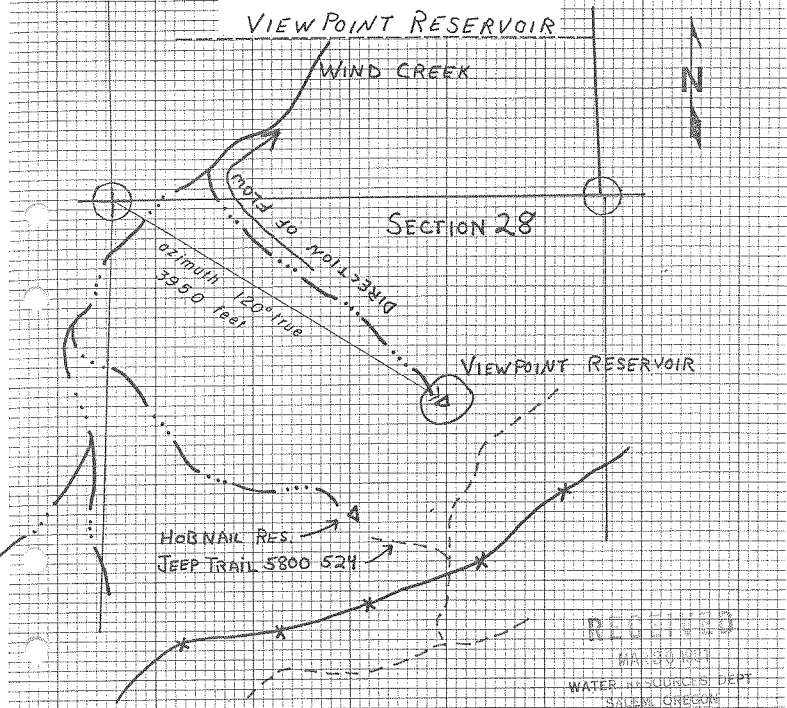

Application No. R-6146
Permit No. R10005

- ~ intermittent stream
- perennial stream
- ⊕ corner monumented
- fence line
- jeep trail

field work by

John Fitzpatrick
John Fitzpatrick

date

5-22-30

plotted by