


Greenwater Reservoir

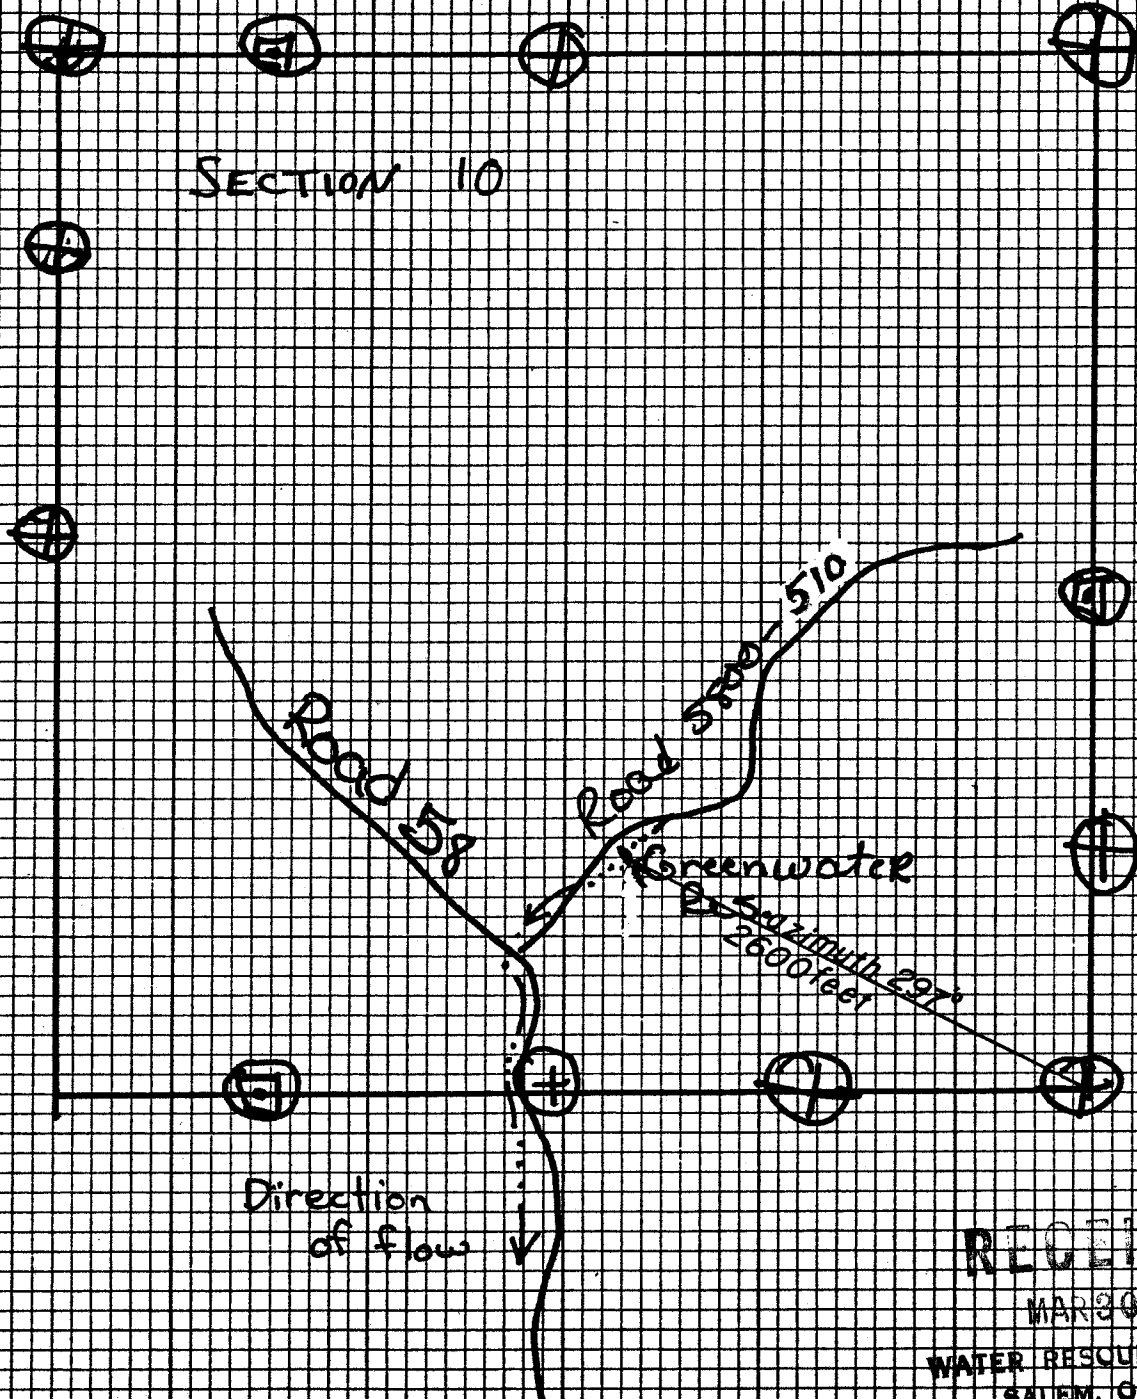

RECEIVED

MAR 20 1981

WATER RESOURCES DEPT
SALEM, OREGON

Application No. R-10006

Permit No. R10006

field work by J. Fitzpatrick + J. Kuhn date 7-7-80

plotted by Judy Kuhn