


R-10009

scale 5.28 inches = 1 mile

T 15 S R 26 E Sec 17 NW 1/4 of SW 1/4

WIND CREEK RESERVOIR

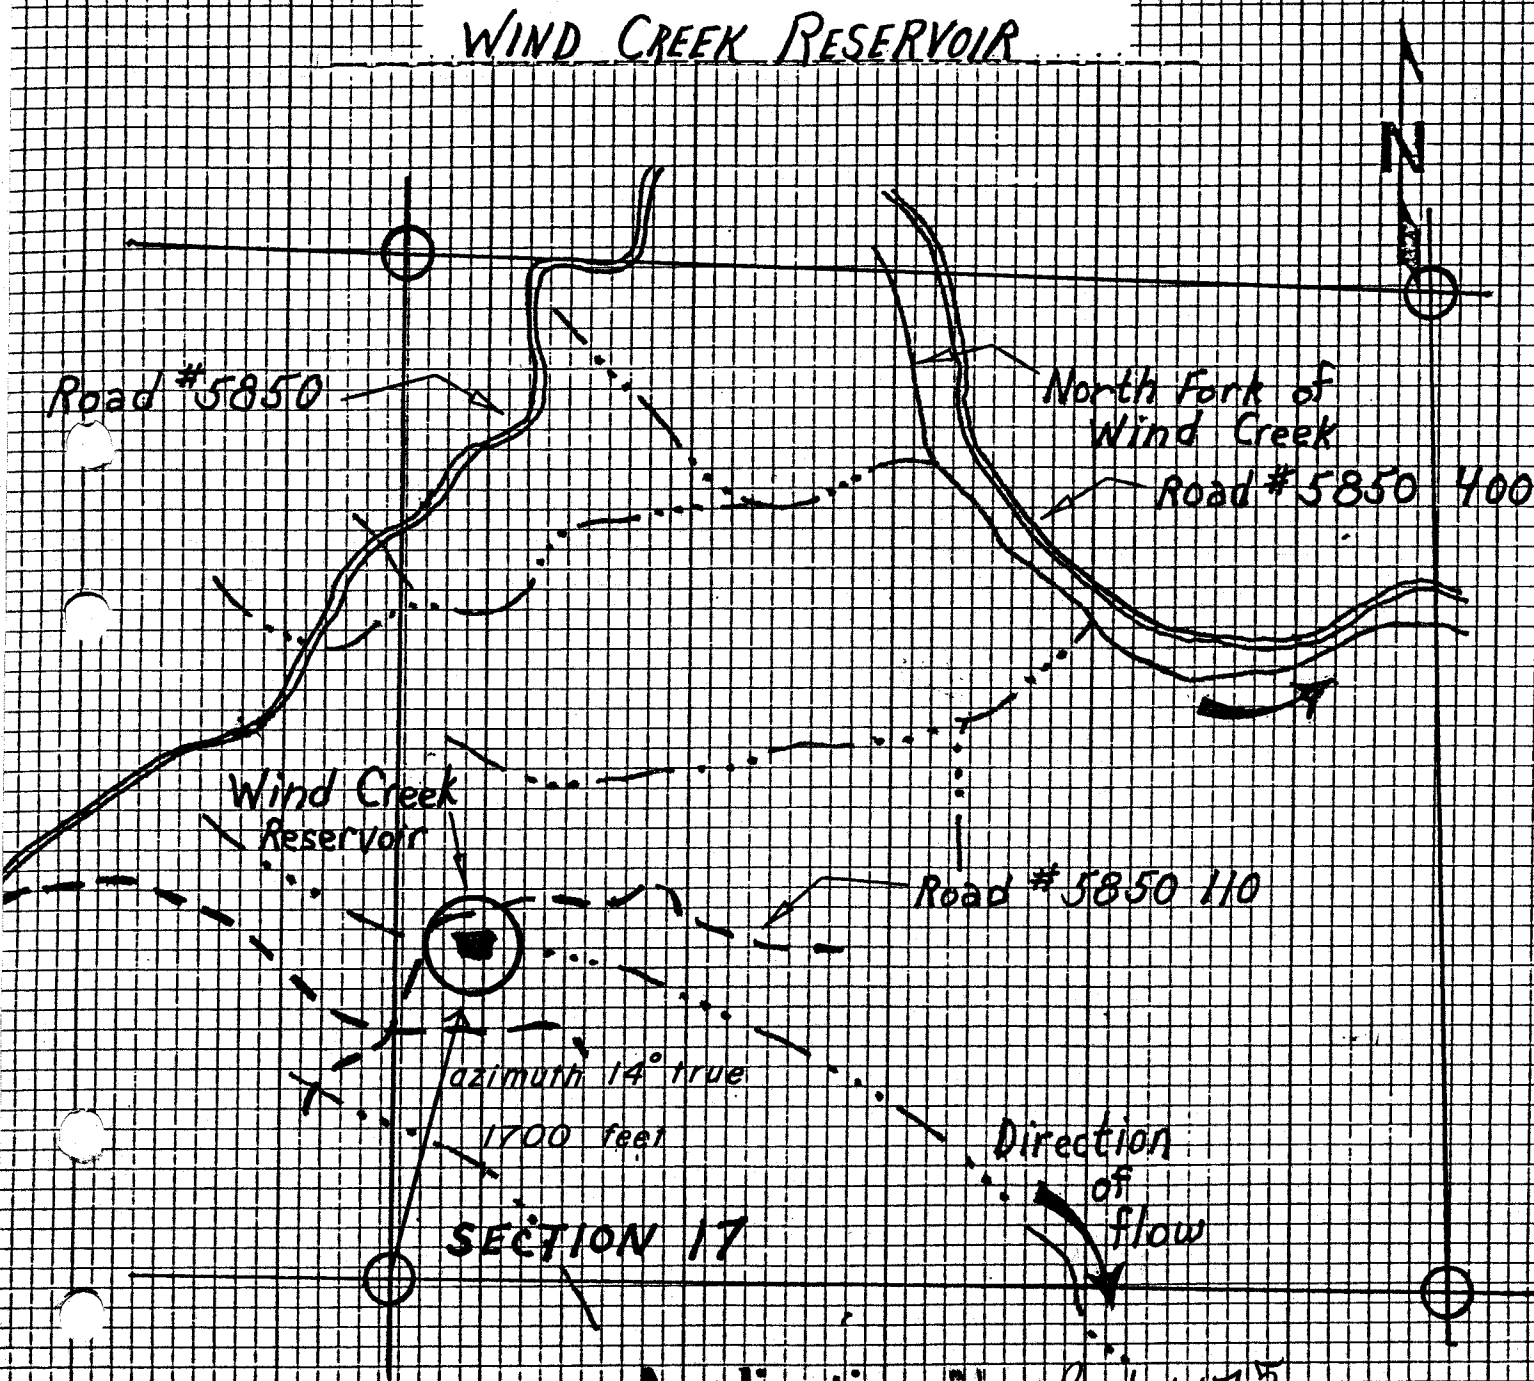

Application No. R-161475
Permit No. R10009

RECEIVED

MAR 30 1981

WATER RESOURCES DEPT
SALEM, OREGON

- intermittent stream
- perennial stream
- ~ Forest Service road
- dirt road
- ⊕ section corner

field work by

J. Fitzpatrick & J. Kuhn

date 6-27-80

plotted by

J. Fitzpatrick