


R-10010

scale 5.28 inches = 1 mile

T 15 S R 26 E Sec 30 NW 1/4 NE 1/4

PALMER RESERVOIR

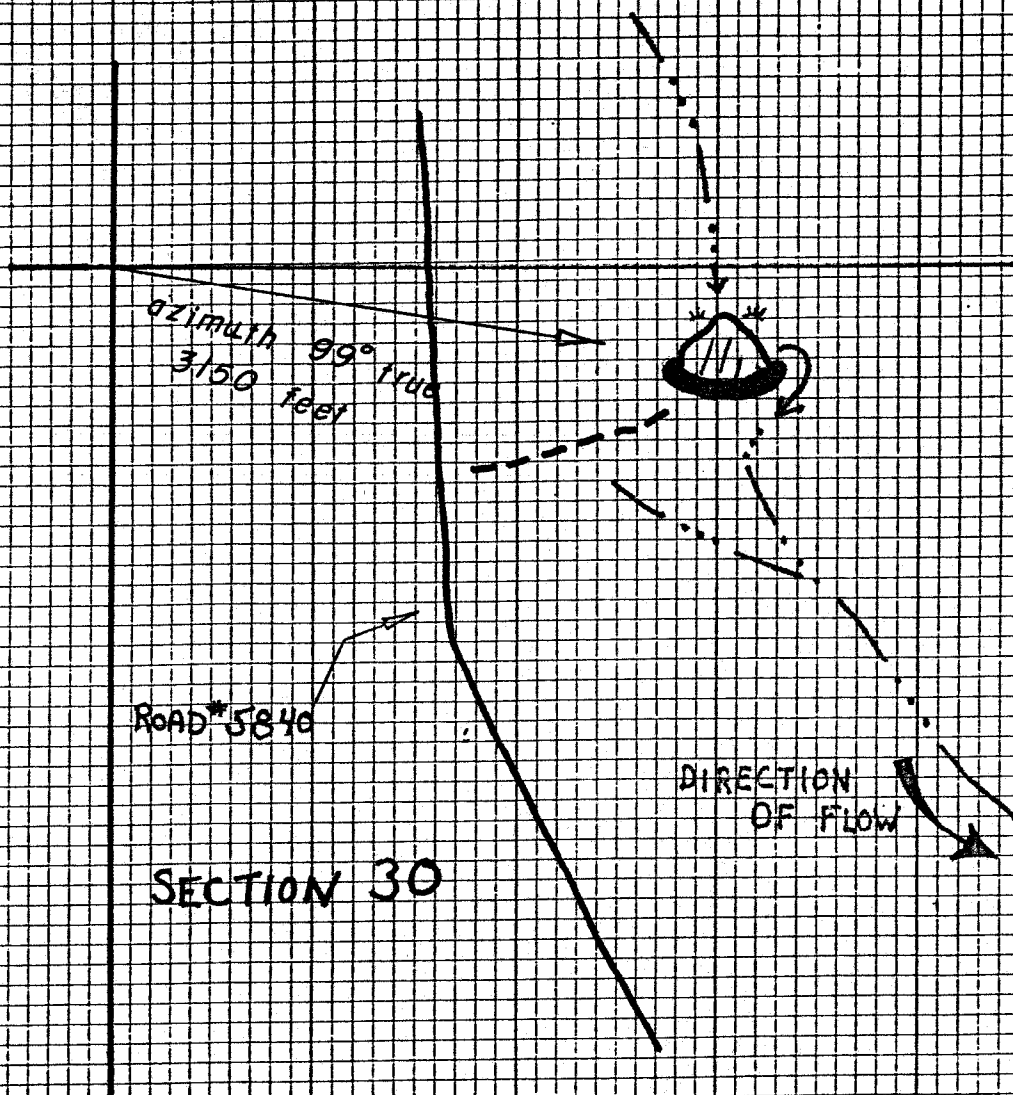

Application No. R-61476
Permit No. R10010

RECEIVED

MAR 30 1981

WATER RESOURCES DEPT
SALEM, OREGON

- reservoir
 - intermittent stream
 - swampy area
 - Forest Service road
- reservoir not to scale

field work by

J. Fitzpatrick & J. Kuhn

date

6-27-80

plotted by

J. Fitzpatrick