


scale 5.28 inches = 1 mile

T 15S R 25E Sec 12 NE 1/4 SW 1

BEAVERDAM RESERVOIR

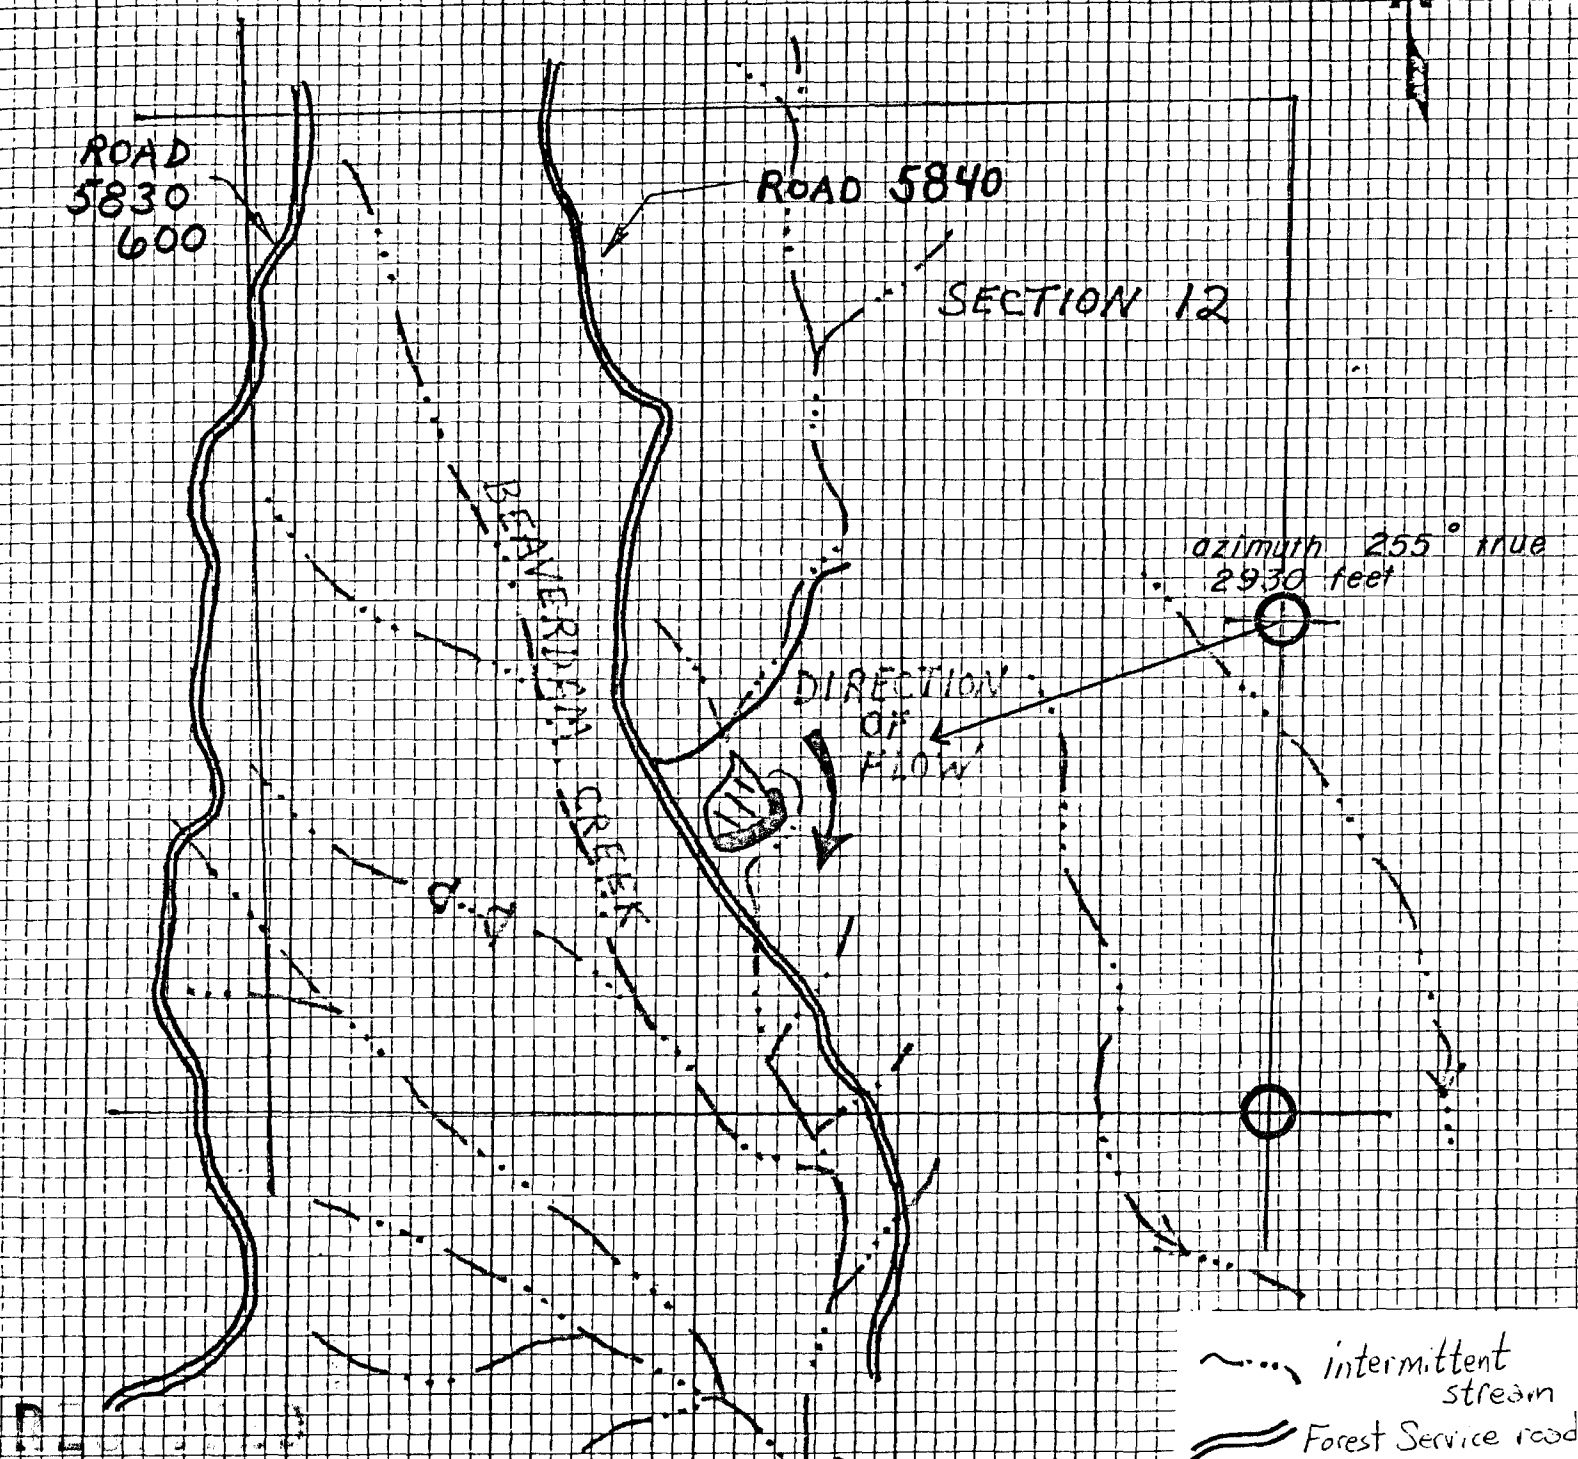

- ~ ~ ~ ~ intermittent stream
- == Forest Service road
- - - Forest Service dirt road
- ⊞ } reservoirs
- ⊞

Beaverdam reservoir not to scale

Application No. R-1477
 Permit No. R10014
 field work by J. Fitzpatrick & J. Kuhn date 12-18-80
 plotted by J. Fitzpatrick

MAR 30 1981
 WATER RESOURCES DEPT.
 SALEM, OREGON