


scale 5.28 inches = 1 mile

T 15S R 22E Sec 15 SE 1/4 of SW 1/4

PAULINA RESERVOIR

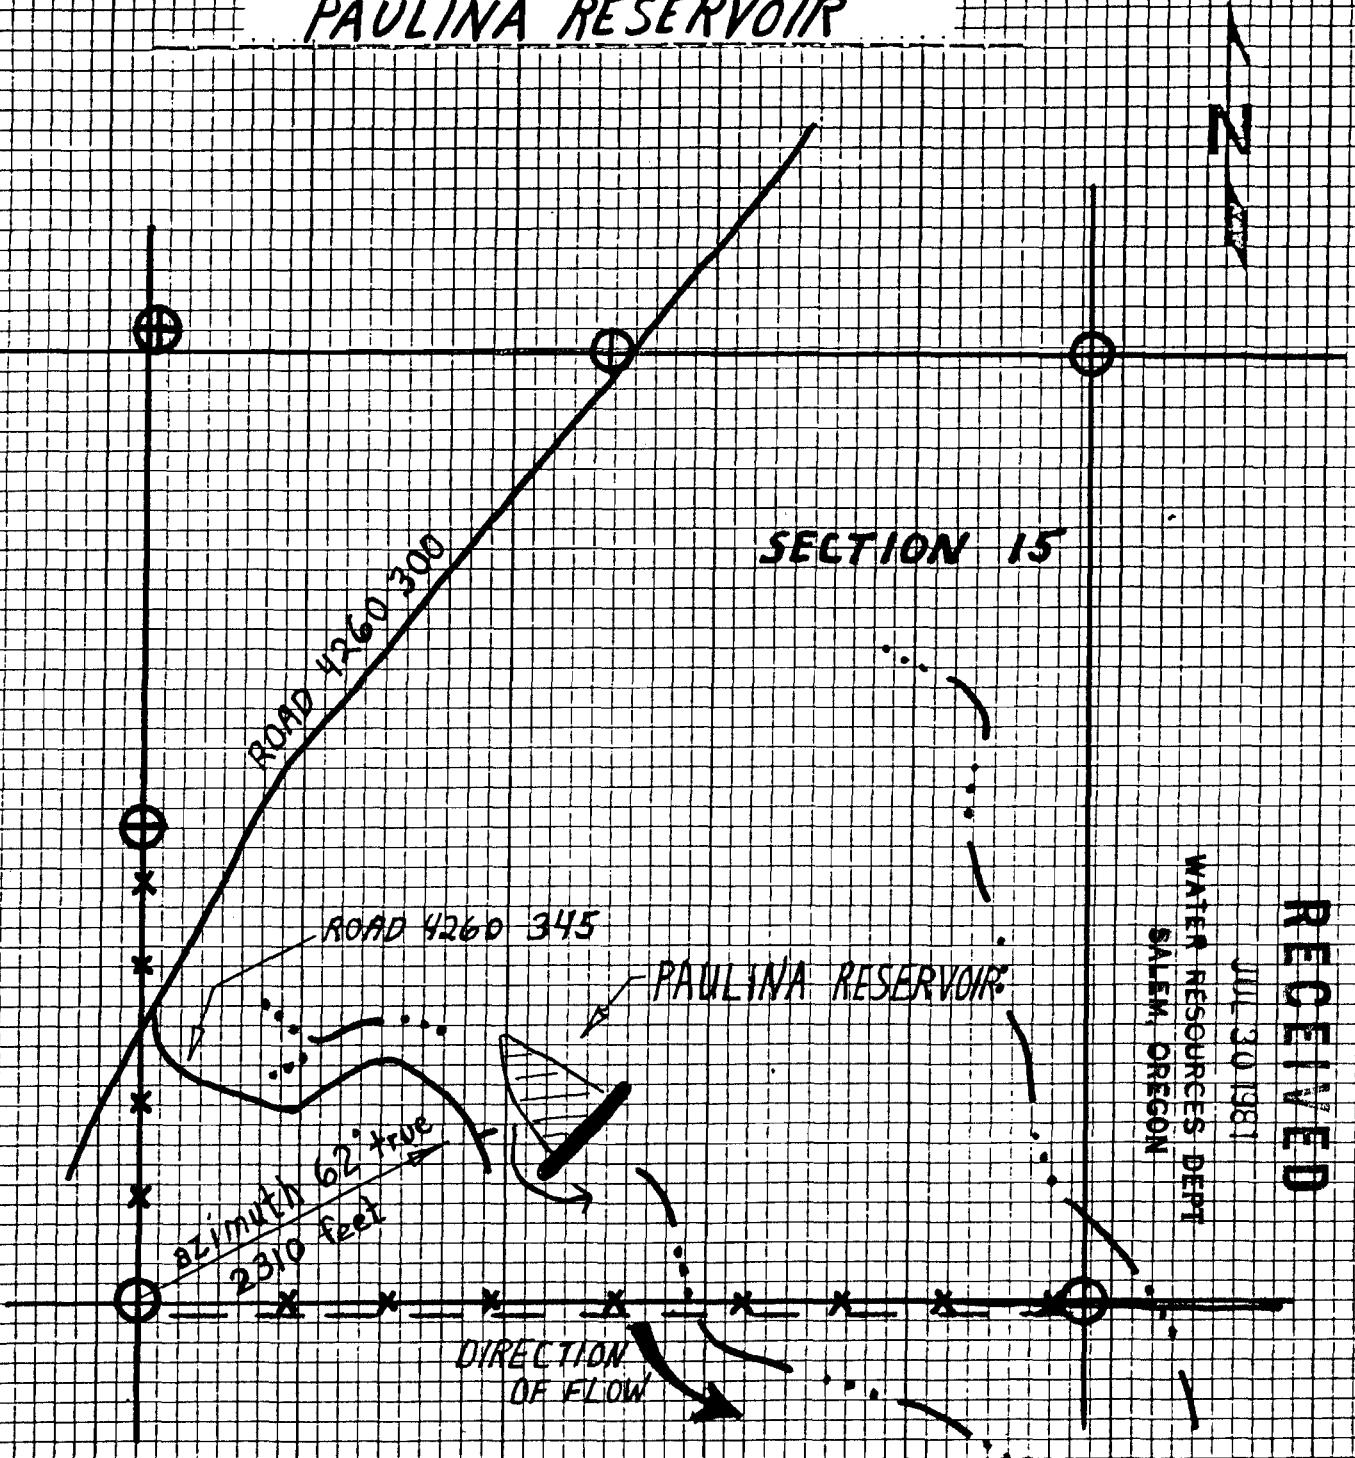

Application No. R-61982
Permit No. R10012

KEY

- RESERVOIR NOT TO SCALE
- forest boundary
- *-*-* fence line
- ~...~ intermittent stream
- ⊕ monumented corners

field work by

J. Fitzpatrick & A. Kuehn

date

4-10-81

plotted by

J. Fitzpatrick