


scale 3.28 inches = 1 mile

T 15S R 25E Sec 12 SW 1/4 of SW 1/4

LITTLE BEAVER RESERVOIR

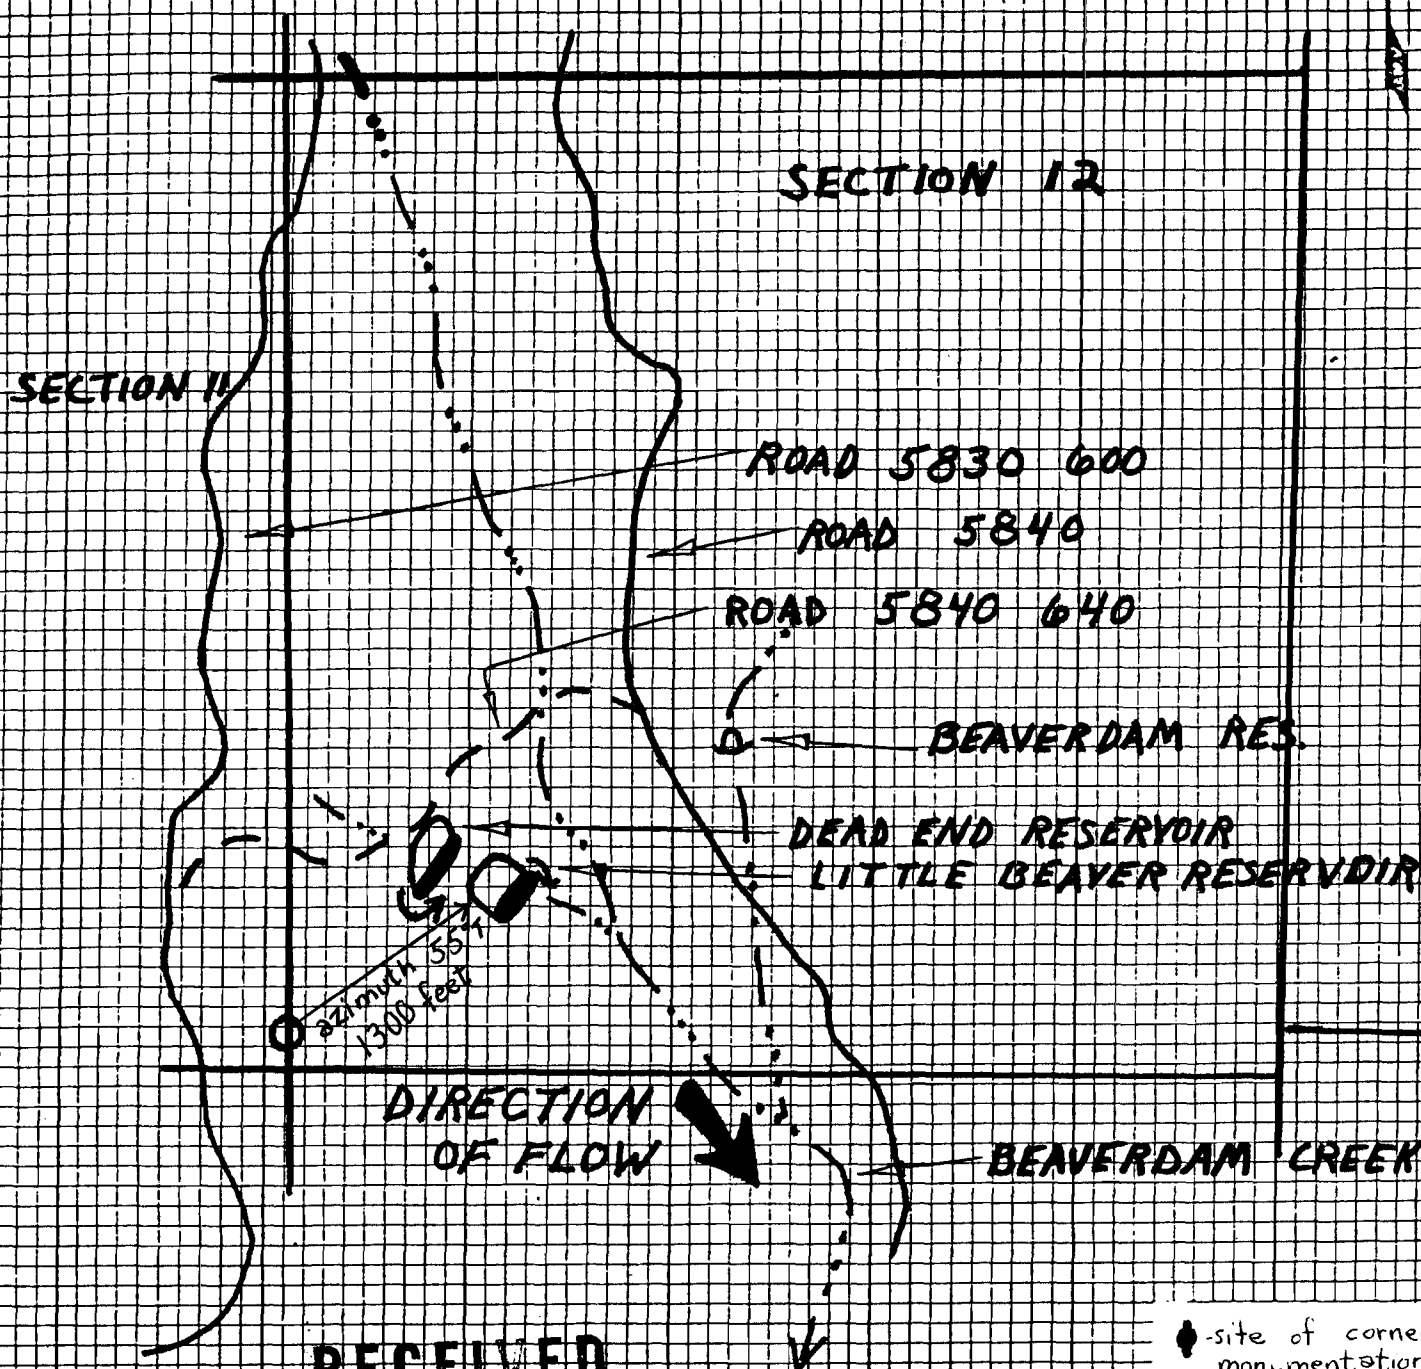

RECEIVED

JUL 30 1981

WATER RESOURCES DEPT
SALEM, OREGON

Application No. R-61983

Permit No. R10013

♦ site of corner
monumentation -
mound of rocks

~...~ intermittent stream

— Forest Service road

- - - dirt road

reservoir not to scale

field work by

J. Fitzpatrick & J. Kuhn
J. Fitzpatrick

date

4-8-81

plotted by