


scale 5.28 inches = 1 mile

HAPPY RESERVOIR

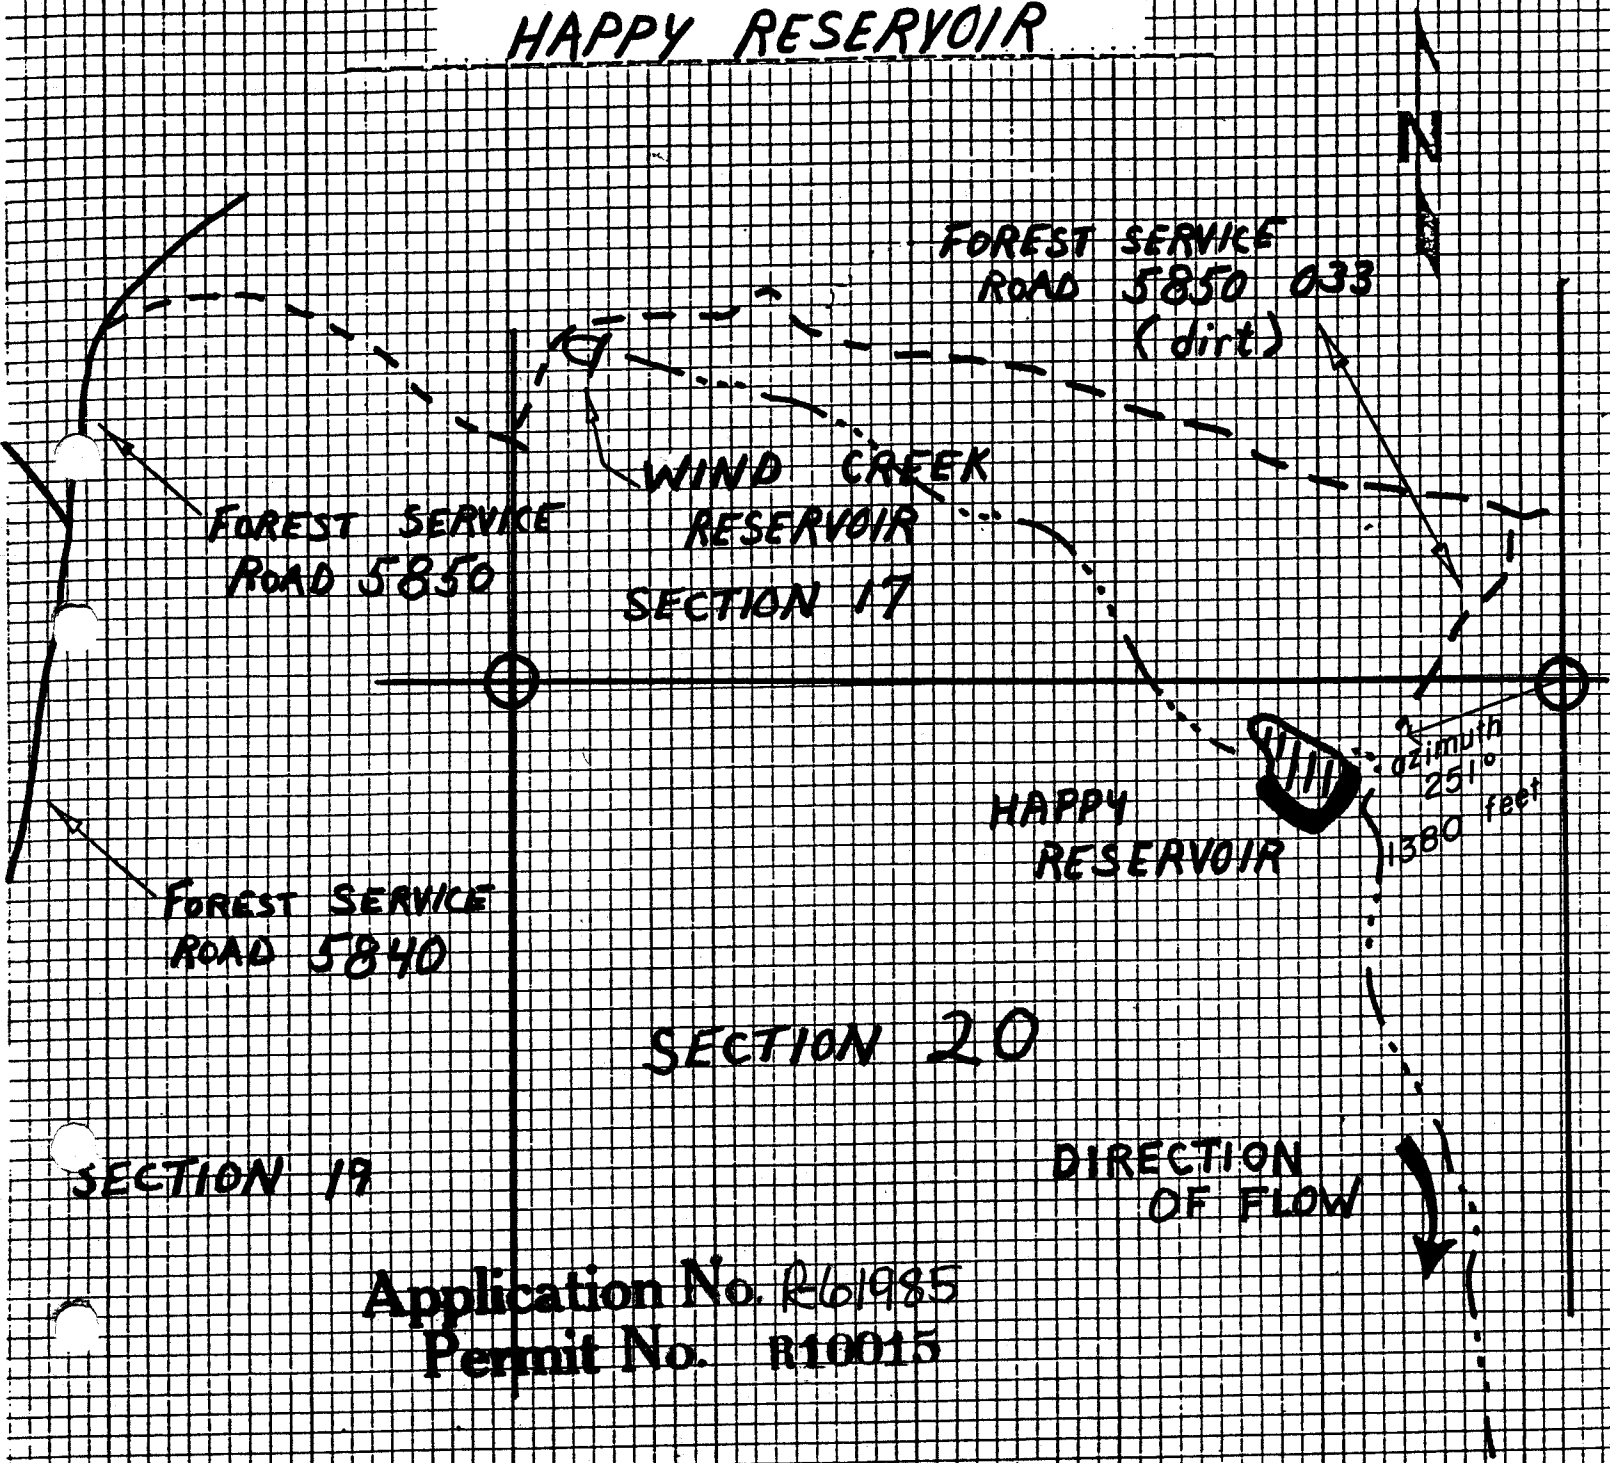

Application No. R61985
Permit No. R10015

RECEIVED

JUL 30 1981

WATER RESOURCES DEPT
SALEM, OREGON

KEY

HAPPY RESERVOIR NOT TO SCALE

- DIRT ROAD
- INTERMITTENT STREAM
- arterial road

field work by

J. Fitzpatrick & J. Xuhm
J. Fitzpatrick

date 6-27-80

plotted by