


RECEIVED

SEP 11 1981

WATER RESOURCES DEPT
SALEM, OREGON

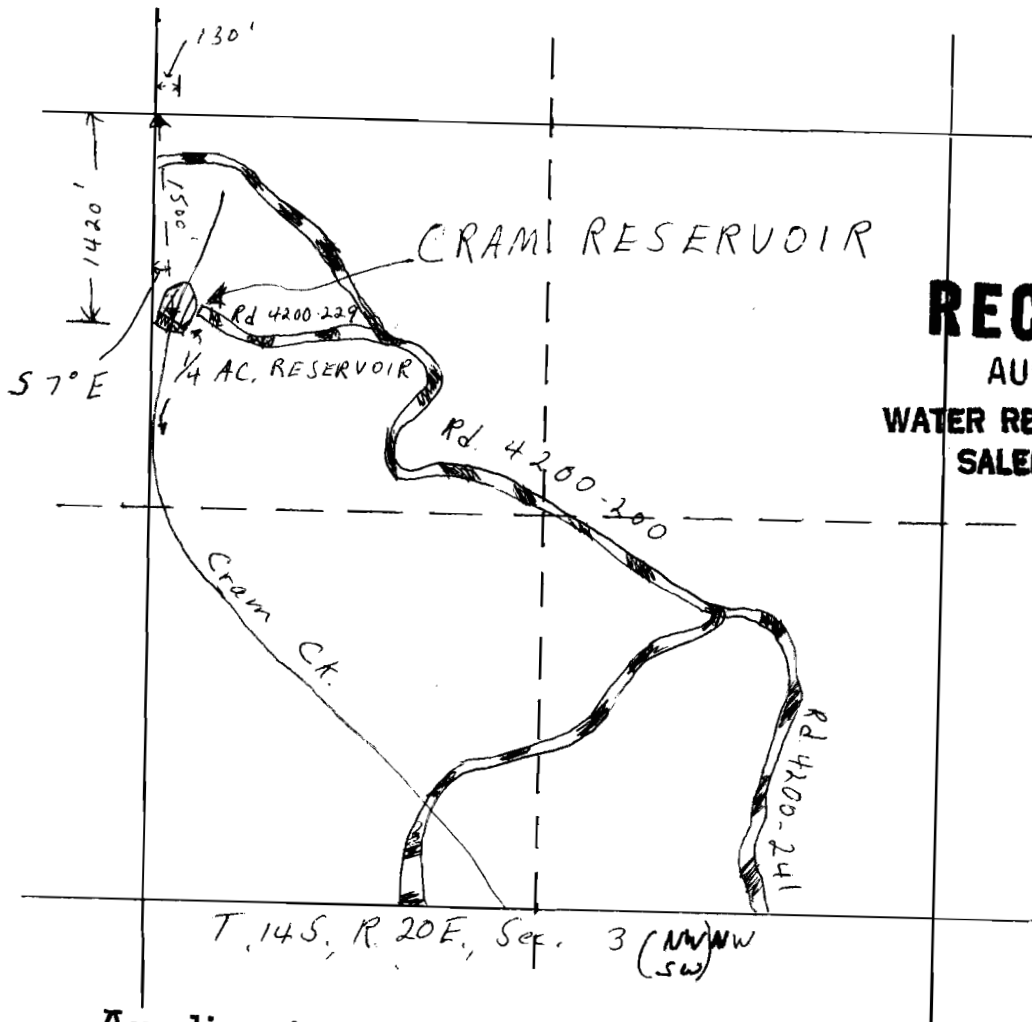

RECEIVED

AUG 8 1983

WATER RESOURCES DEPT.
SALEM, OREGON

Application No. R-62671
Permit No. R10016

SCALE: 4 Inches = 1 Mile

NORTH

