


T. 2 N. R. 12 E. W.M.

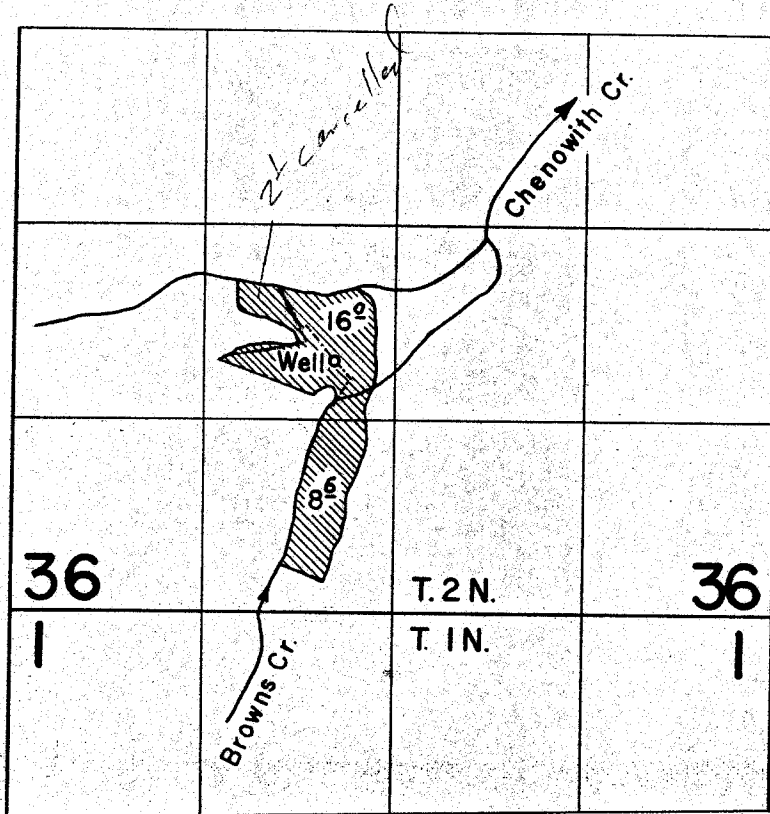

FINAL PROOF SURVEY
UNDER

Application No. G-3..... Permit No. G-178.....
IN NAME OF

.....Karl F. Thomsen.....

Surveyed April 8..... 1963., by *A.W. Jelousek*