


# T. 7 S. R. 2 W. W.M.

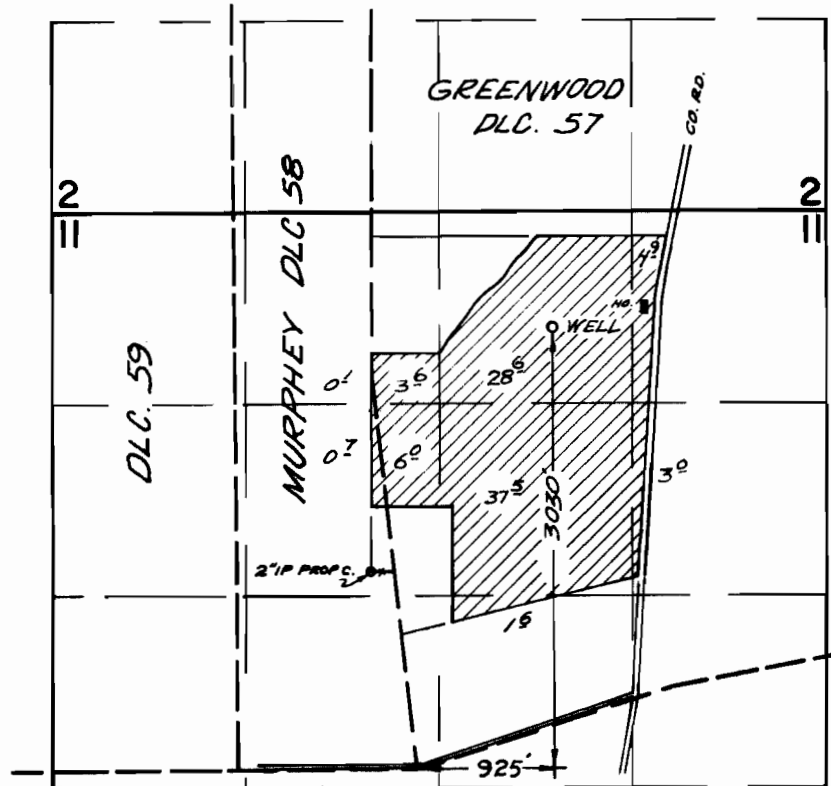

## FINAL PROOF SURVEY UNDER

Application No. *G-1758*. Permit No. *G-1670*..  
IN NAME OF

*DANIEL H. ROSS*

Surveyed *Nov. 20*. 1967, by *V. Garner*.....