


T. 39S., R. 8W., W.M.

Sec. 28

SW 1/4 NE 1/4

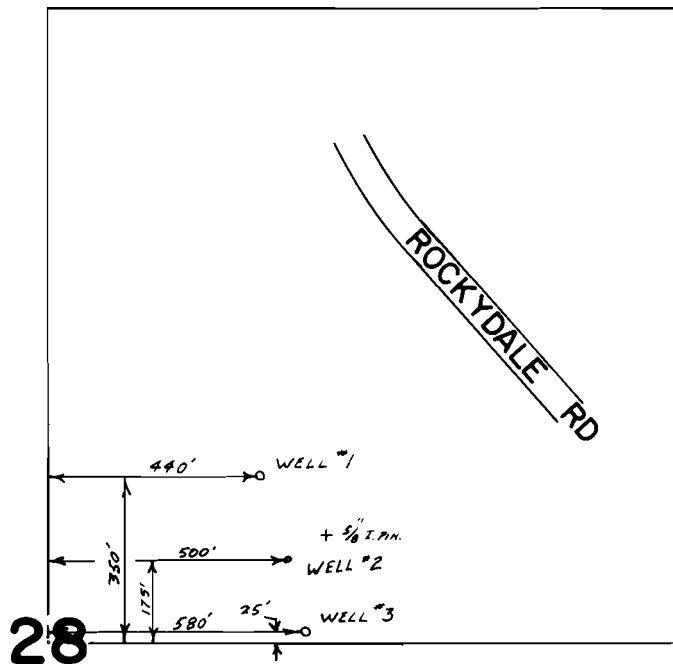

Scale 1" = 400'

FINAL PROOF SURVEY
UNDER

Application No. G-2767 Permit No. G-2570....
IN NAME OF

CITY of CAVE JUNCTION.....

Surveyed Aug. 24. 1982, by B.R. SUND.....