


# T.3S.R.4W.W.M.

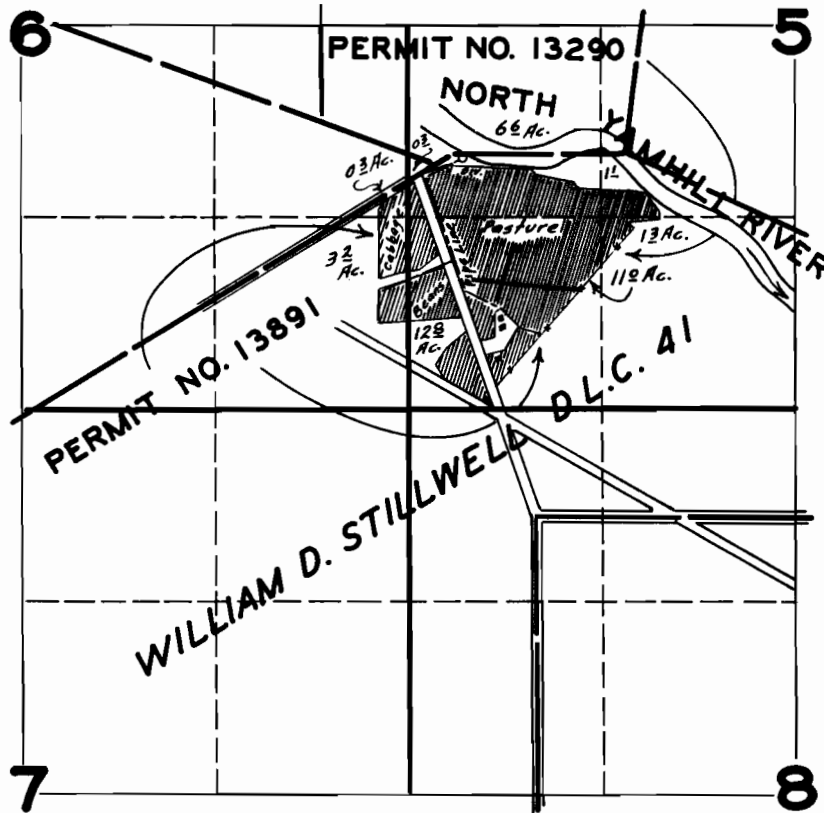

## FINAL PROOF SURVEY

UNDER

Application No. 17594 18230 Permit No. 13290 13891

IN NAME OF

BOB B. WEBB

Surveyed SEP. 6 1946, by [Signature]