


# T. 1 S. R. 3 W. W. M.

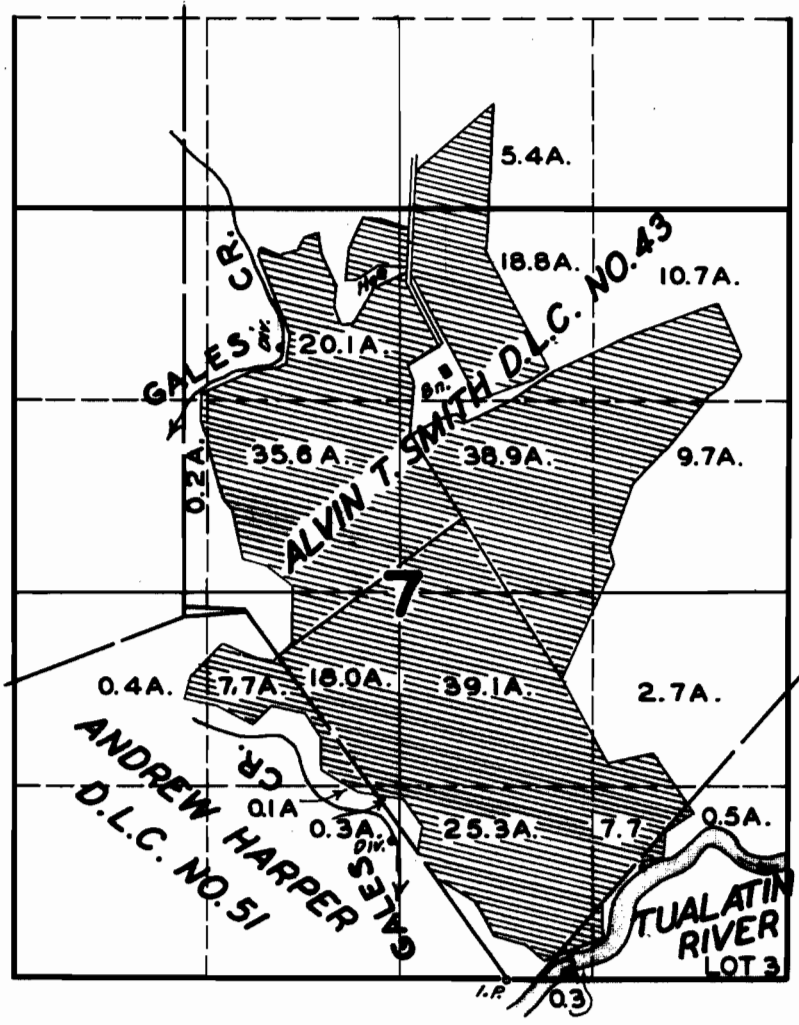

## FINAL PROOF SURVEY UNDER

Application No. 19257... Permit No. 14836...  
IN NAME OF

GLENN W. ZURCHER

Surveyed MAY 24, 1948, by JAS. E. BUNNELL