


T.20 S.R.3 W.W.M.

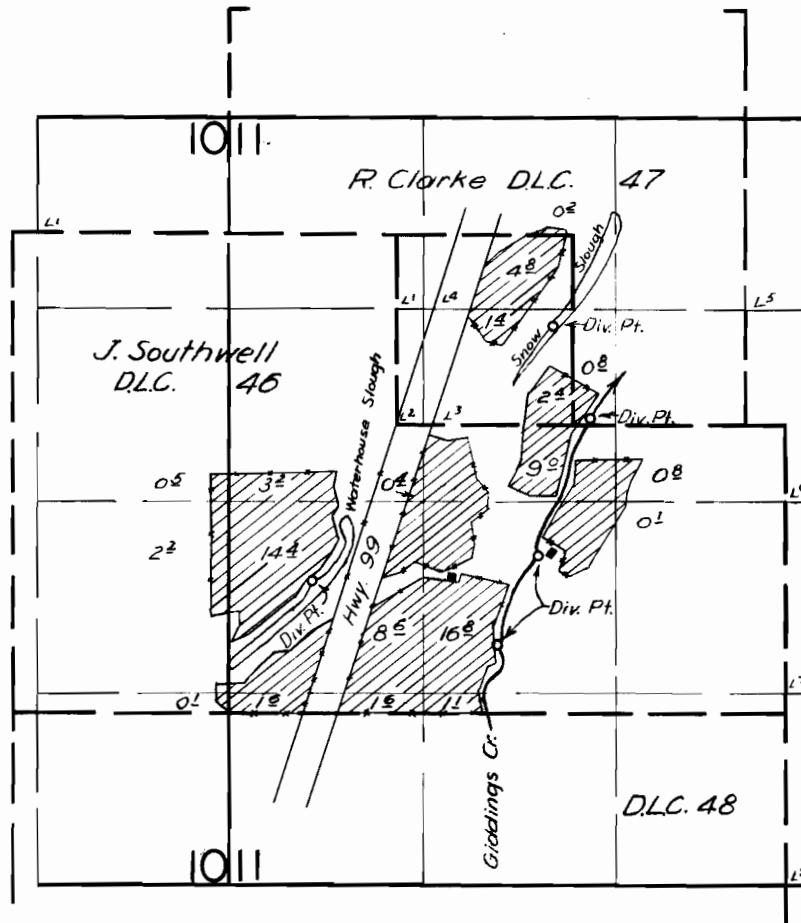

FINAL PROOF SURVEY UNDER

Application No. 28214 Permit No. 22440
IN NAME OF

The S & A Company

Surveyed April 16, 1957, by *M. Bish*