

T. 34 S., R. 1 W., W.M.


RECORDED
54717
WATER RESOURCES DEPT
SALEM, OREGON

SE 1/4 NW 1/4

Lot 5

SW 1/4 NE 1/4

Lot 2

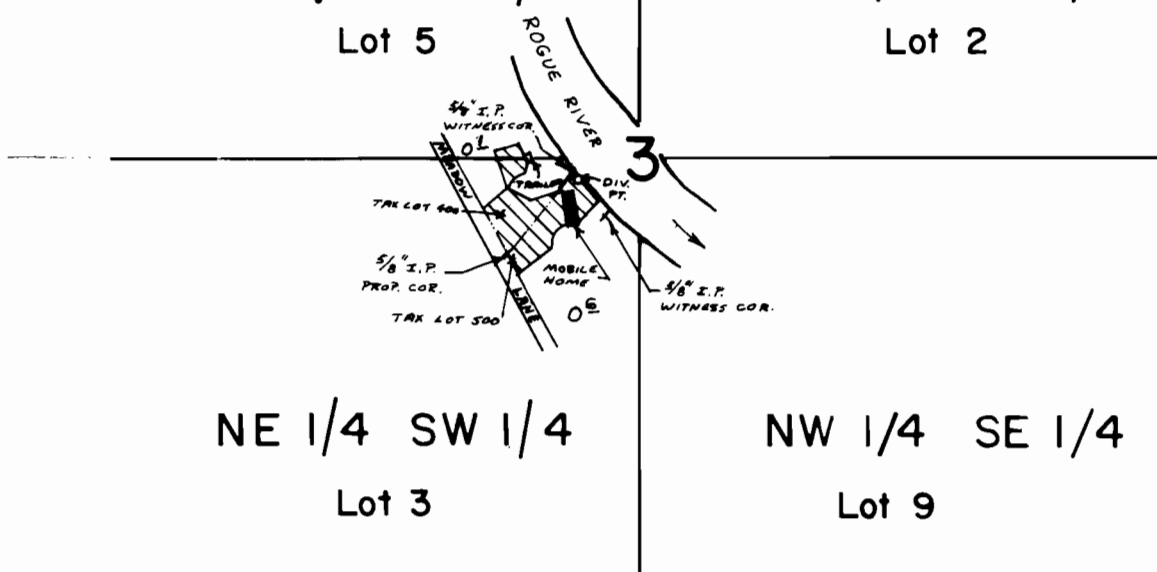

DIV. PT.: 40'S. & 120' W. from CEN., SEC. 3.

Scale: 1" = 400'

FINAL PROOF SURVEY
UNDER

Application No. 54717... Permit No. 41049.....
IN NAME OF

JACQUELINE.....ABELL.....STRANGMAN

Surveyed Sept. 10, 1981, by B.R. SUND.....