


T.16S.R.48&5W.W.M.

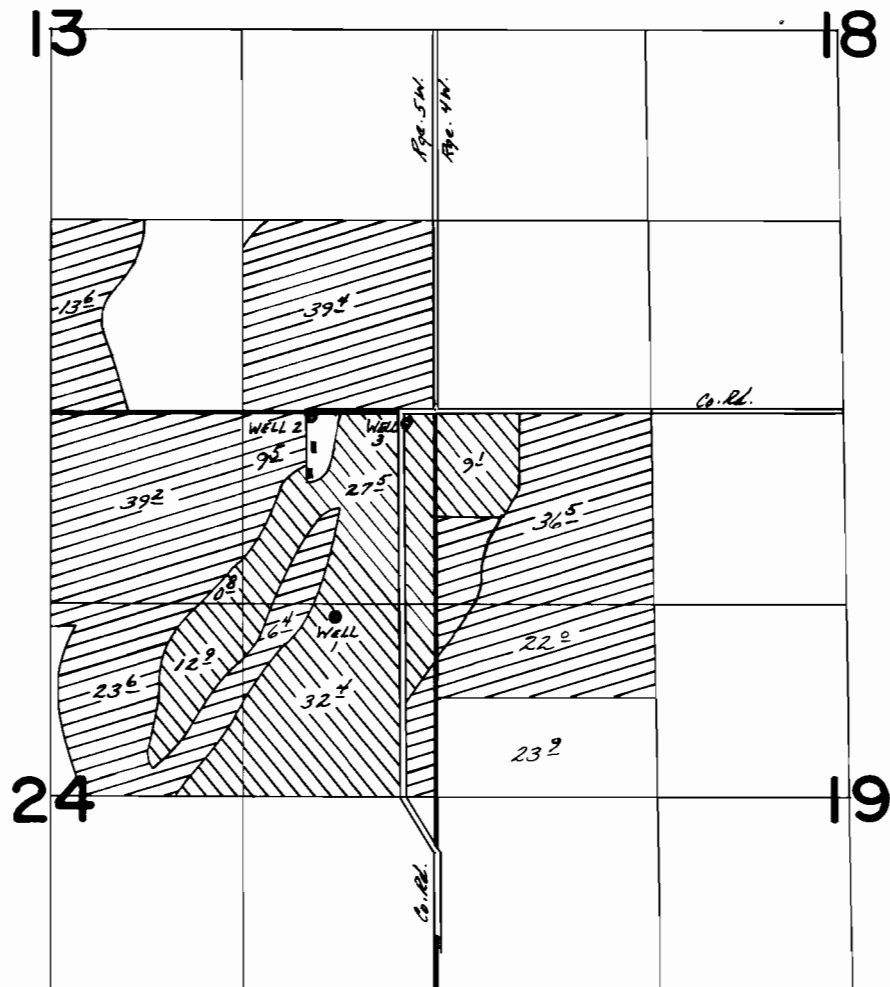

LOCATION OF WELLS;

1- 1410'S. & 680'W.

2- 25'S. & 840'W.

3- 62'S & 204 W

ALL FROM NE COR. SEC. 24

FINAL PROOF SURVEY

UNDER

Application No. G-6874. Permit No. G-6676....
IN NAME OF

.....CARL E. HUNTON.....

Surveyed May...18... 1979, by S.C. BROWN.....