


# T. 8 S. R. 39 E. W.M.

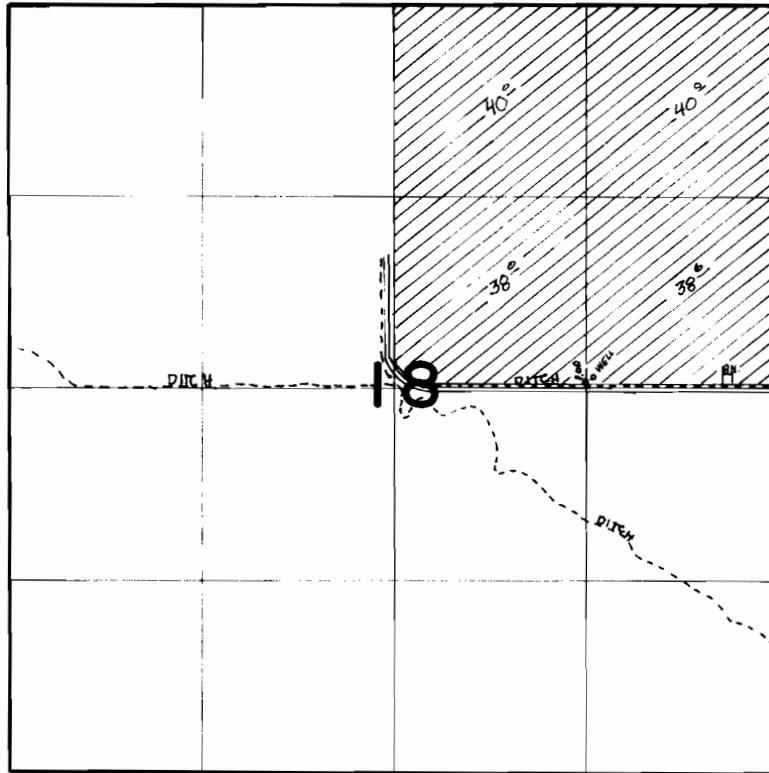

SCALE: 1" = 1320'



WELL LOCATED 50' NORTH AND 1260' WEST FROM EAST 1/4 CORNER, SEC. 18

## FINAL PROOF SURVEY UNDER

Application No. G-8590 Permit No. G-7917.....  
IN NAME OF

**VIRGIL W. BORGER**

Surveyed 5-21 1984, by V.L. CHURCH.....