


T. 38 S., R. 5 W., W.M.

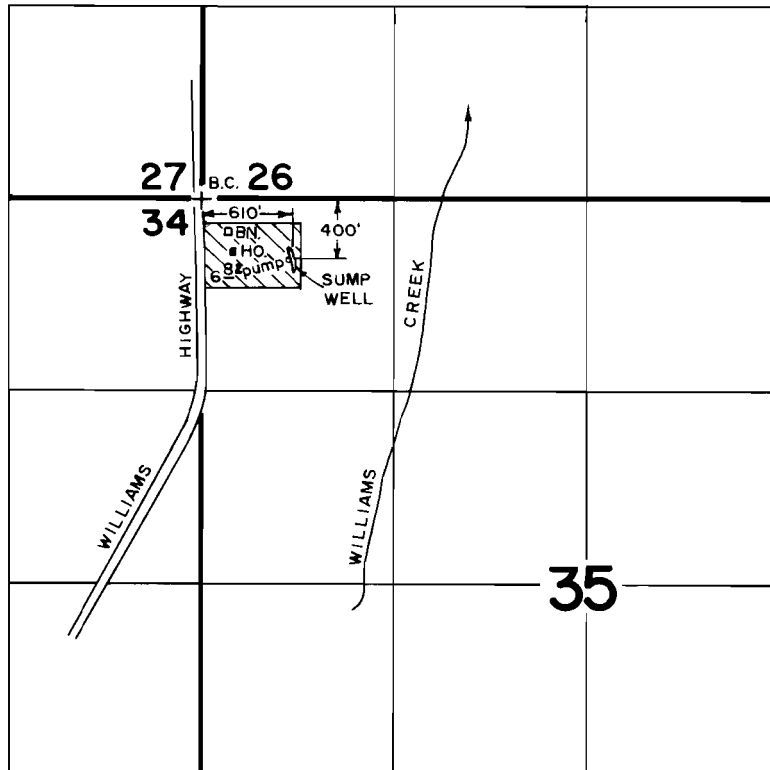

**FINAL PROOF SURVEY**  
UNDER

Application No. **G-8463** Permit No. **G-7923**  
IN NAME OF

**KENNETH T. ZETLMAIER**

Surveyed **AUG. 10, 1983**, by **B. SUZIE JAMES**

SCALE: **4" = 1 MILE**