


T. 14 S., R. 6 W., W. M.
SECTION 23

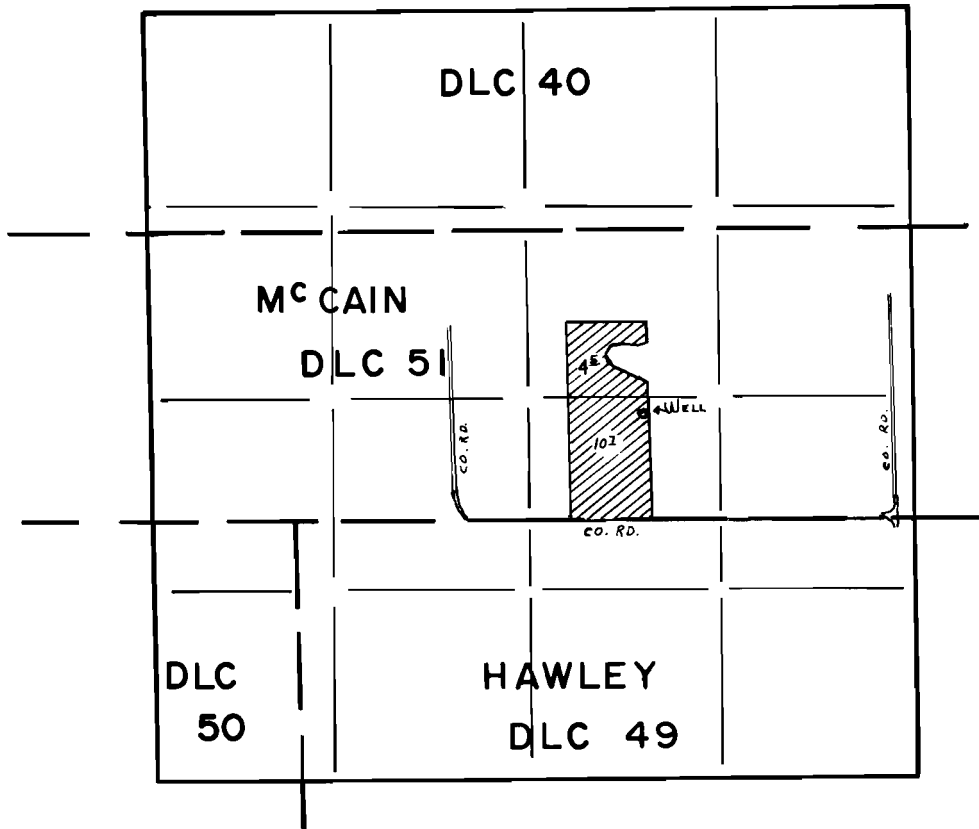

Well Loc.: 700' N. & 2425' E. from the NW Cor.
HAWLEY DLC 49

FINAL PROOF SURVEY
UNDER

Application No. G-8513 Permit No. G-7939
IN NAME OF

ALBERT GORDEN BERDAHL

Surveyed JUNE 29, 1983, by L. TOLL