


G7970
60031

T. 1S., R. 32E., W. M.

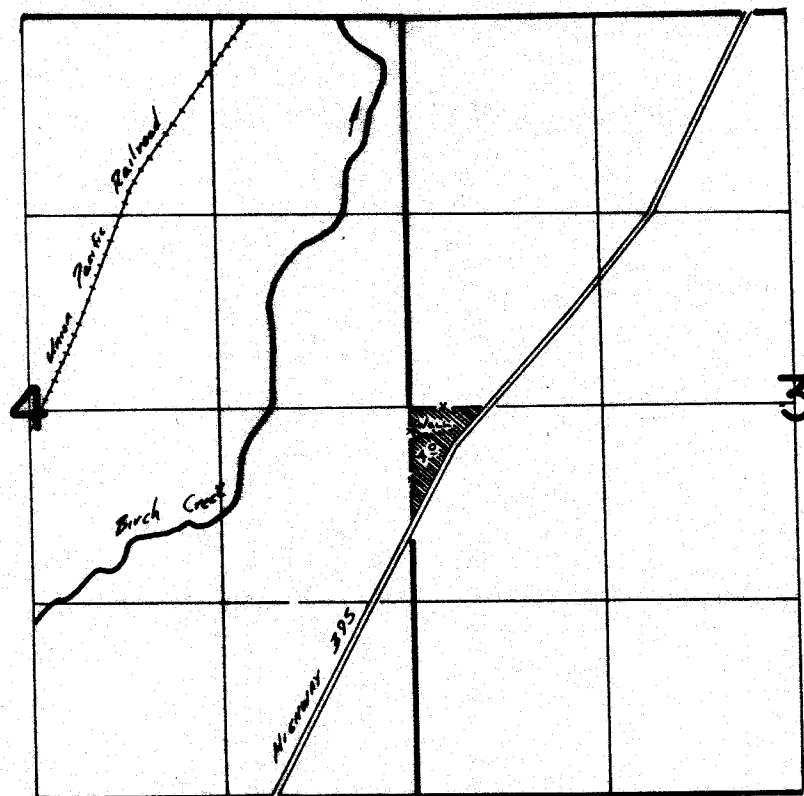

Well Loc: 180'S. & 50'E. From W 1/4 Cor Sec 3

FINAL PROOF SURVEY
UNDER

Application No. **G-8499** Permit No. **G-7970**
IN NAME OF

WILLIAM J. ELFERING

Surveyed May 17, 1983, by **W.L. Church**