


T. 3 N. R. 21 E. W.M.

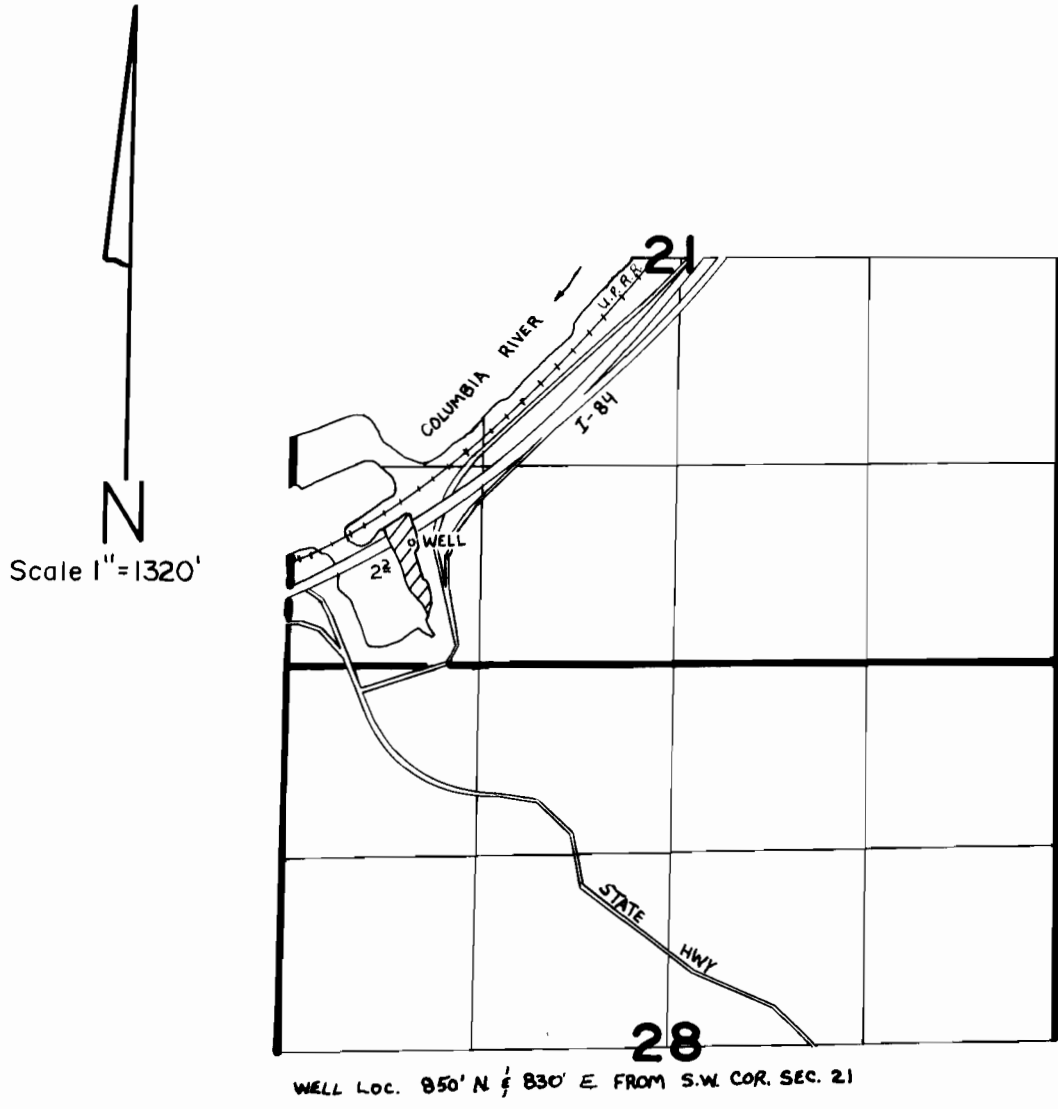

FINAL PROOF SURVEY UNDER

Application No. G.5852.. Permit No. G.8113.....
IN NAME OF

PORTLAND DIST. CORPS. OF ENGINEERS

Surveyed May 12... 1986., by V. Church.....