


T.9S., R.4W., W.M.

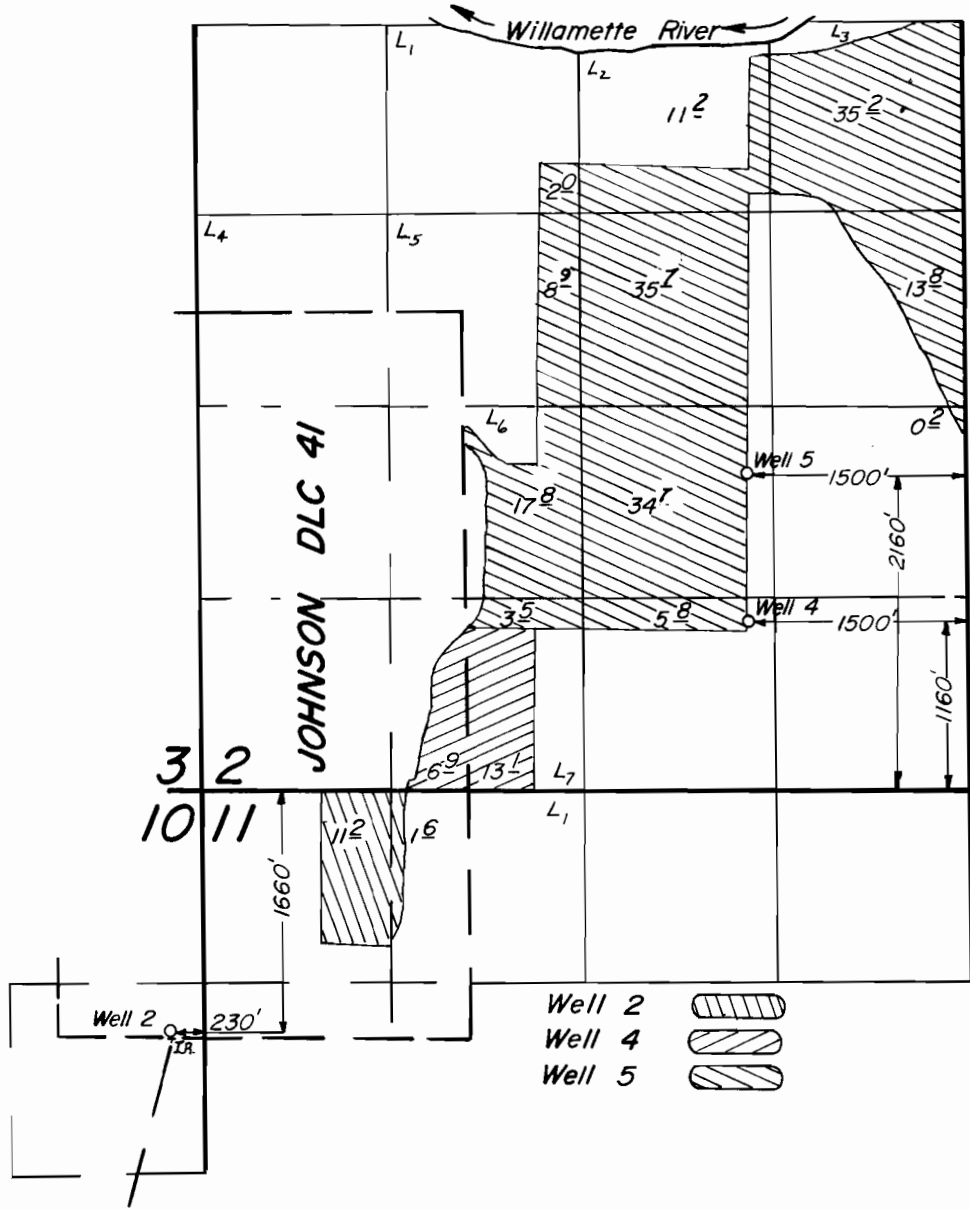

Scale : 1" = 1320'

FINAL PROOF SURVEY UNDER

Application No. G-8845 Permit No. G-8216.....
IN NAME OF

WIGRICH FARM, INC.

Surveyed Sept. 5 1984, by Pete Pagter.....