


T. 9S., R. 4W., W. M.

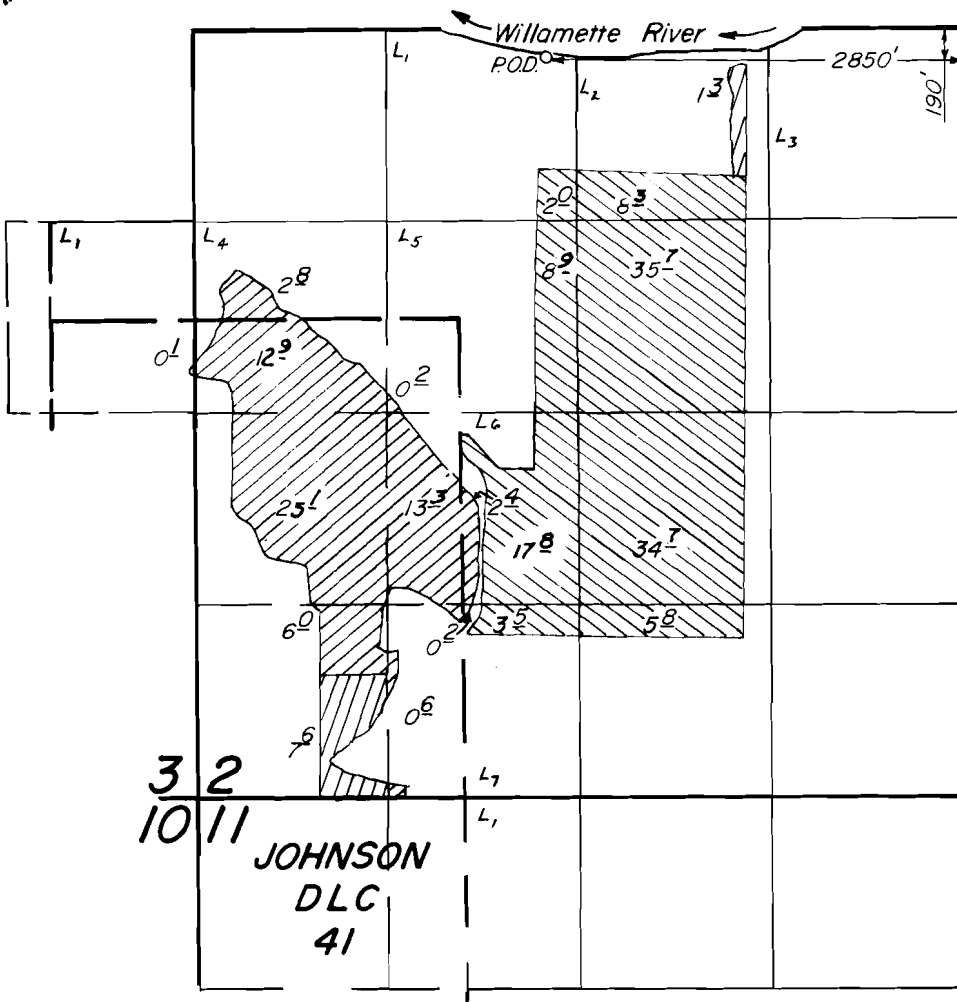

Scale: 1" = 1320'

FINAL PROOF SURVEY UNDER

Application No. 57505 Permit No. 43381
 60150 45092
 IN NAME OF

WIGRICH FARM, INC.

Surveyed Sept. 5, 1984, by Pete Pagter

