


T.5&6S.,R.3W.,W.M.

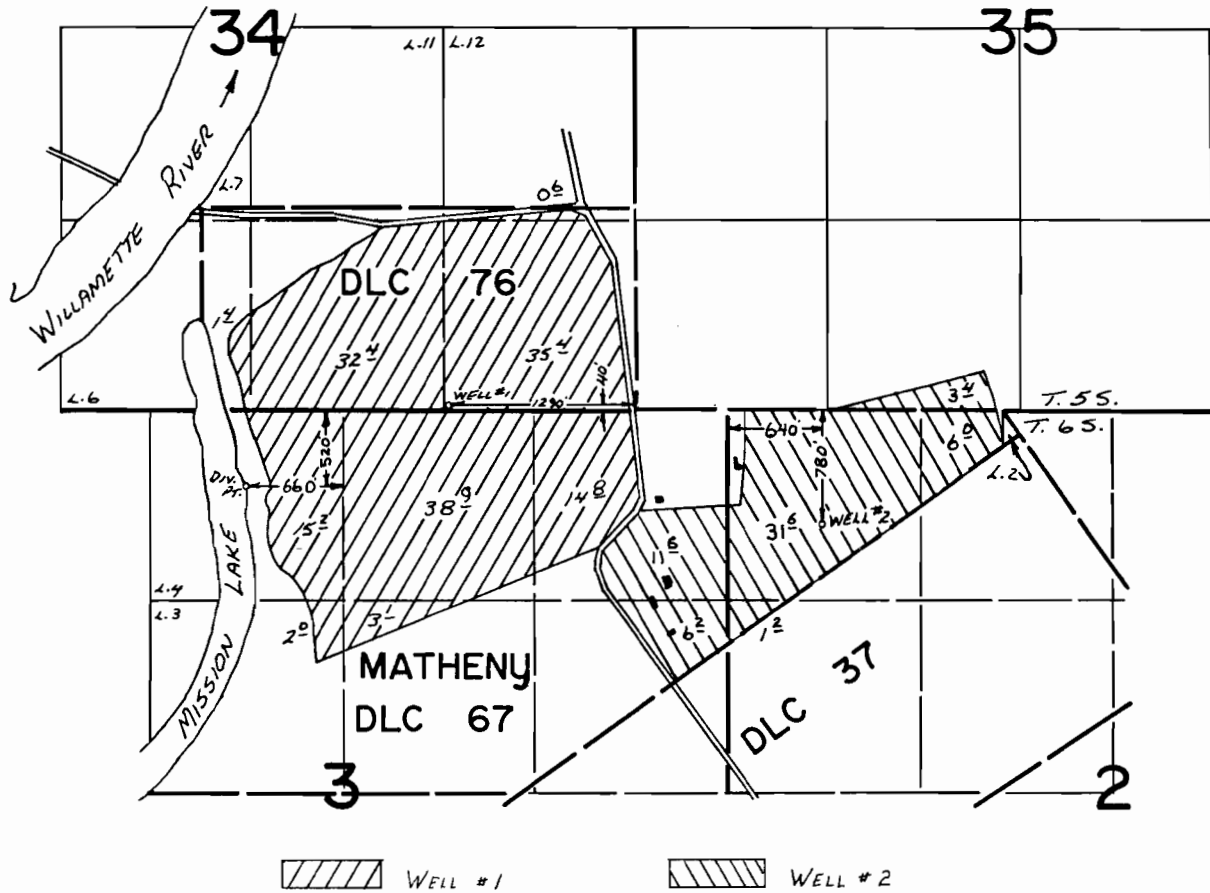

FINAL PROOF SURVEY

UNDER

Application No. G-7773 Permit No. G-8350

IN NAME OF

BYRON HADLEY LAFOLLETTE

Surveyed Apr. 24, 1979, by L. H. Nunn