


68400
60037

T. 3S., R. 26E., W. M.

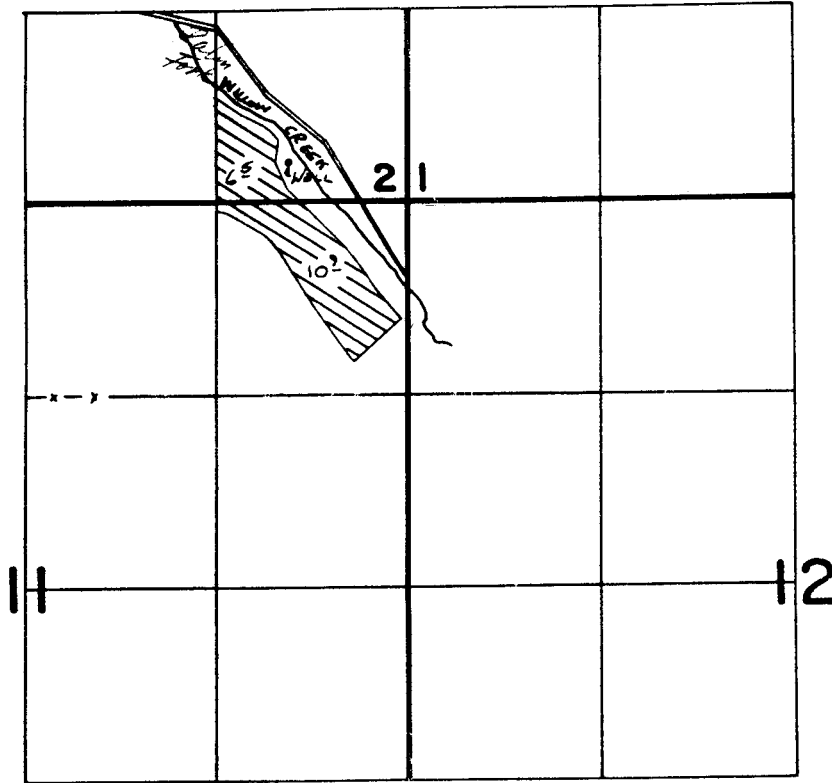

Well Loc: 270' N. & 820' W. FROM SE COR. SEC 2

FINAL PROOF SURVEY
UNDER

Application No. **G-8933** Permit No. **G-8400**
IN NAME OF

ALBERT L. OSMIN

Surveyed Feb. 24 1987, by V.L. Church