


G-8433
60038

T. 39S. R. 10E. W. 1M.

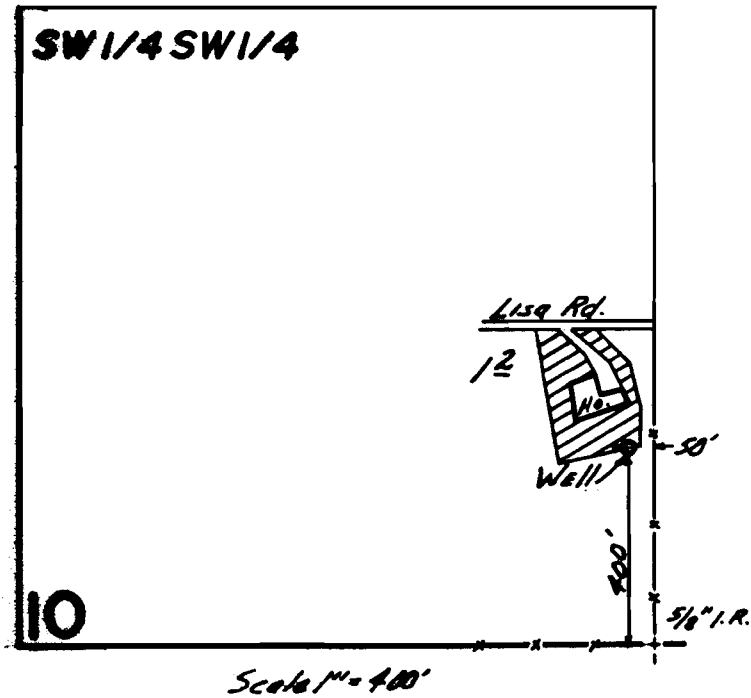

FINAL PROOF SURVEY UNDER

Application No. G-8968 Permit No. G-8433...
IN NAME OF

.....DUANE BLACKMAN.....

Surveyed Sept..20. 1979., by C.R.RODRIGUEZ...