

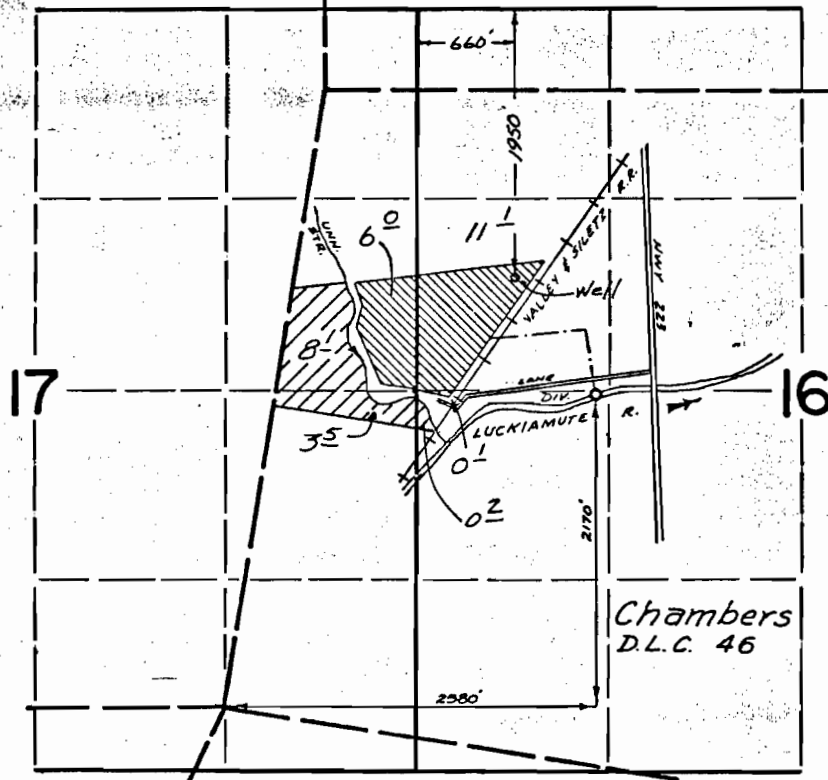
JACK E. MAHANA

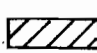

Application No. 65210

Permit No. 47654 T. 10 S., R. 6 W., W.M.

Application No. G 8915

Permit No. G 8439



 ~~primary~~ THIS APPLICATION
 ~~supplemental~~

FINAL PROOF SURVEY
UNDER

RECEIVED
JUN 0 1983
WATER RESOURCES DEPT.
SALEM, OREGON

Application No. 43400 Permit No. 32450
IN NAME OF

JACK F. MOORE

Surveyed Mar. 21 1973, by D. NORBY