


# T.7S.,R.2W.,W.M.

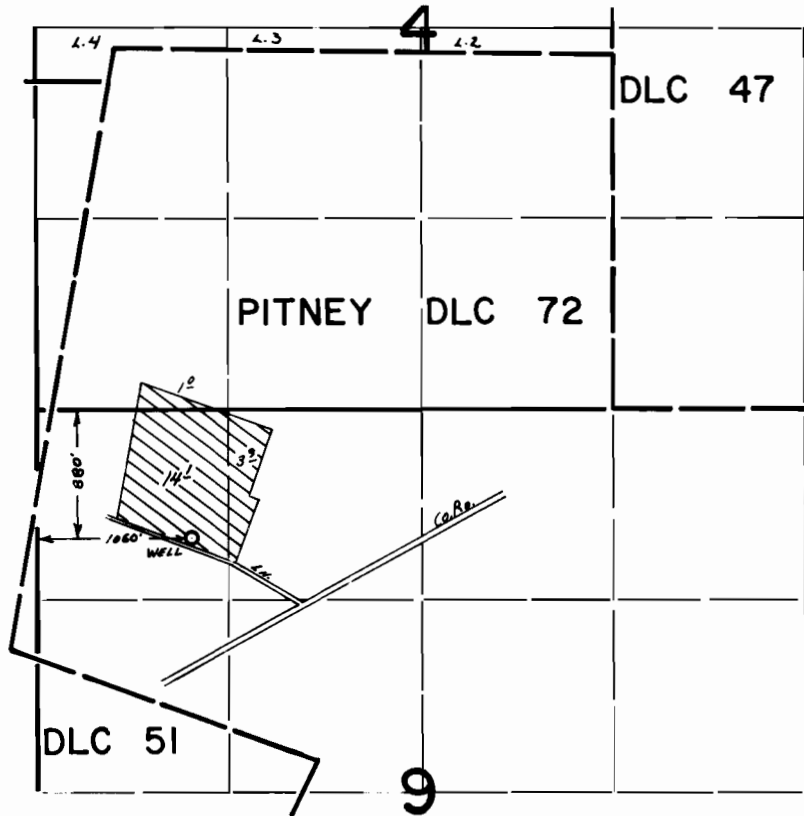

## FINAL PROOF SURVEY UNDER

Application No. G-9135.. Permit No. G-8462.....  
IN NAME OF

.....EMORY J. GOODE.....

Surveyed Oct., 30... 19.81., by S.C. BROWN.....