


T.9S.,R.1W.,W.M.

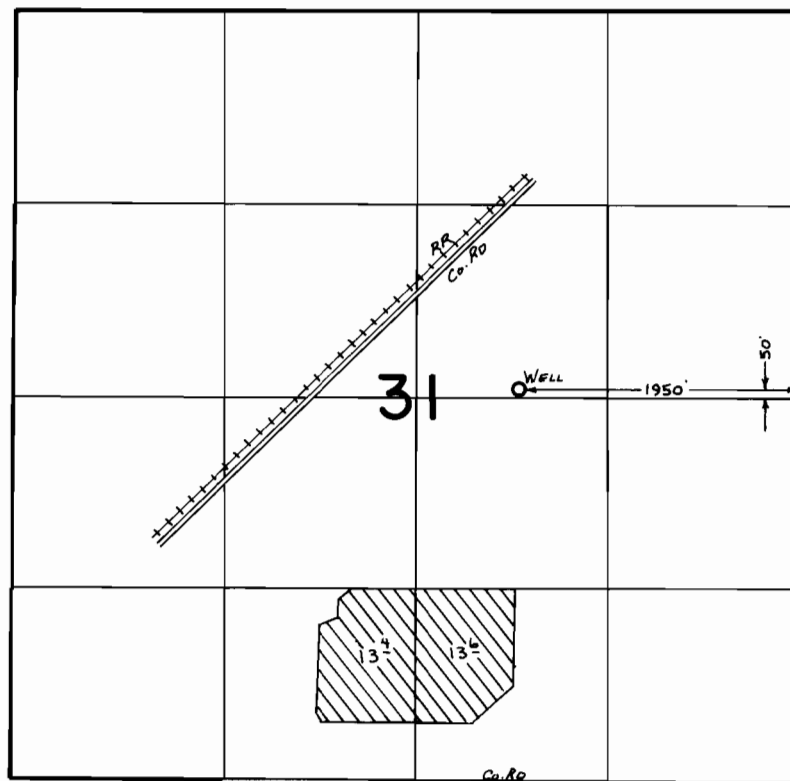

FINAL PROOF SURVEY
UNDER

Application No. G:9137. Permit No. G:8463....
IN NAME OF

JOE SCHUMACHER

Surveyed July 7, 1982, by L.M. TOLL