


T.16 S., R.11 E., W.M.

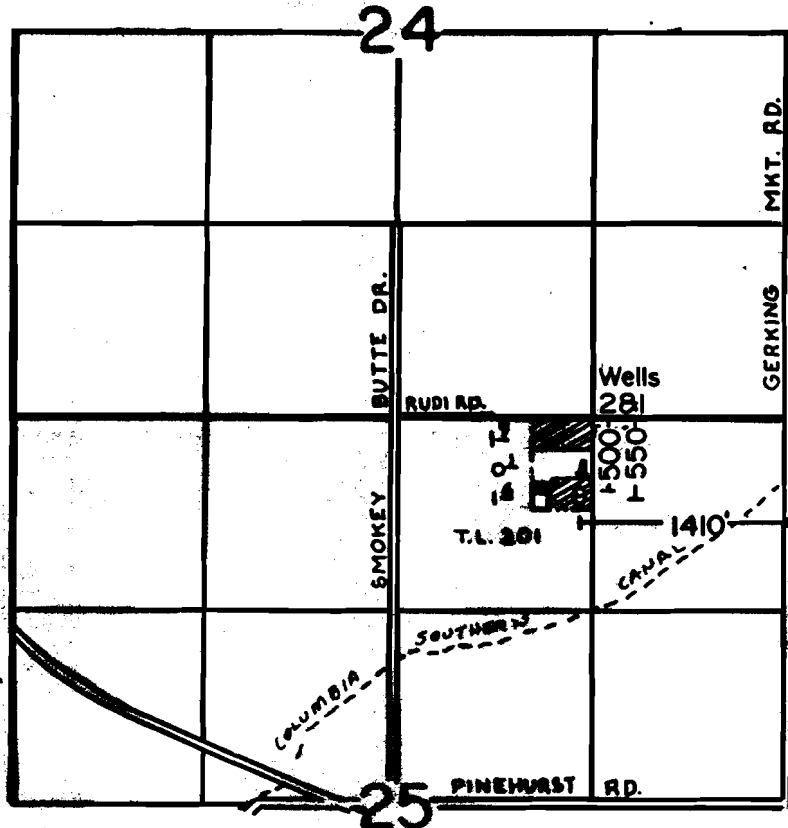

SCALE: 1" = 1320'

FINAL PROOF SURVEY
UNDER

Application No. G-8974. Permit No. G-8466....
IN NAME OF

Cert; 60045

O. S. FLAHERTY

Surveyed JULY...18... 1985., by LESLIE OLSON....

RECEIVED

DATE 3-15-89
WATER MASTER DISTRICT #11
BY SMS