


# T. 10 S., R. 2 W., W.M.

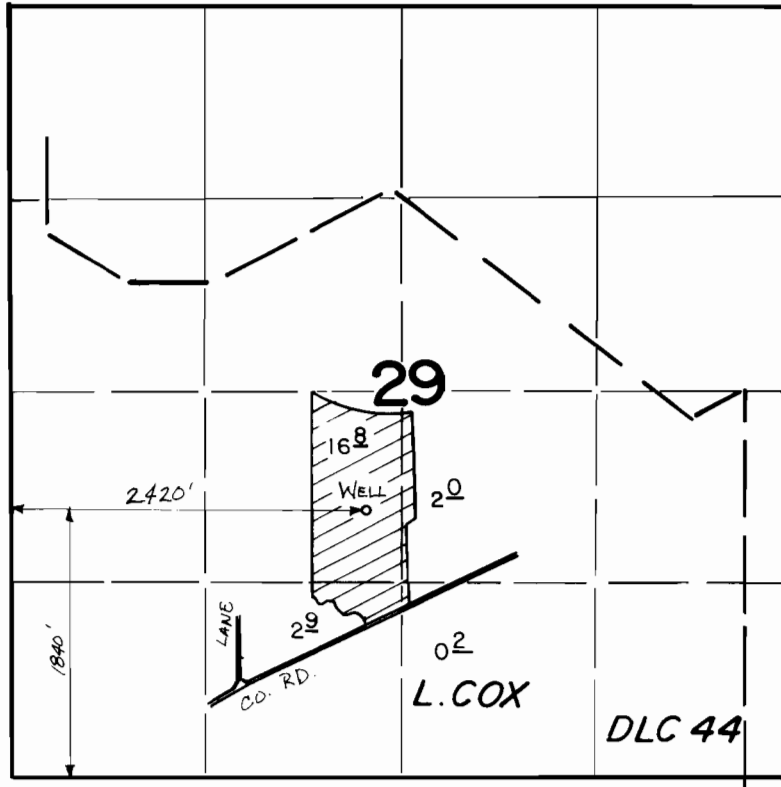

1" = 1320'

## FINAL PROOF SURVEY UNDER

Application No. G-8829 Permit No. G-8478  
IN NAME OF

**JOHN E. HAYES**

Surveyed OCT. 19, 1983, by M. CAHILL