


T. 9S., R. 1W. & 1E., W. M.

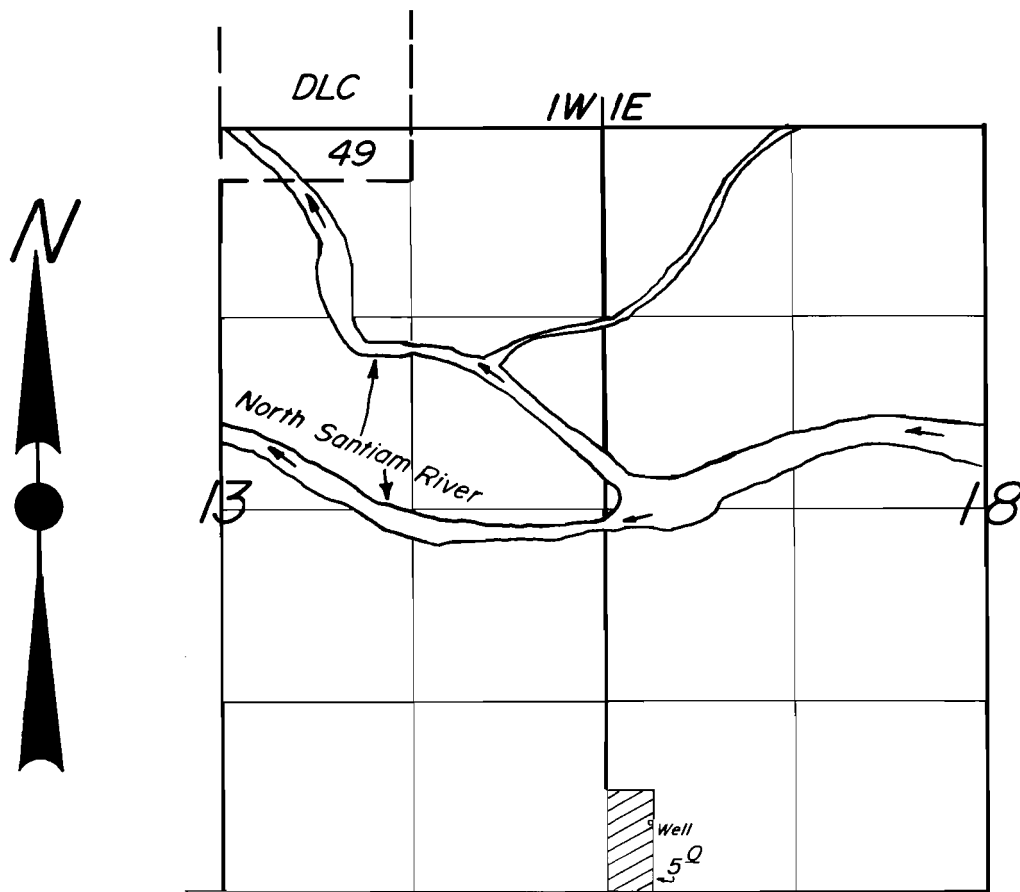

Well Location : 480' N. & 300' E. from SW. Cor. Sec. 18.

Scale: 1" = 1320'

FINAL PROOF SURVEY **UNDER**

Application No. *G-9168*. Permit No. *G-8482*....
IN NAME OF

GEORGE DEAN ARCHIBALD

Surveyed *April 26, 1984*, by *Ben Bishop*.....