


T.7S., R.2W., W.M.

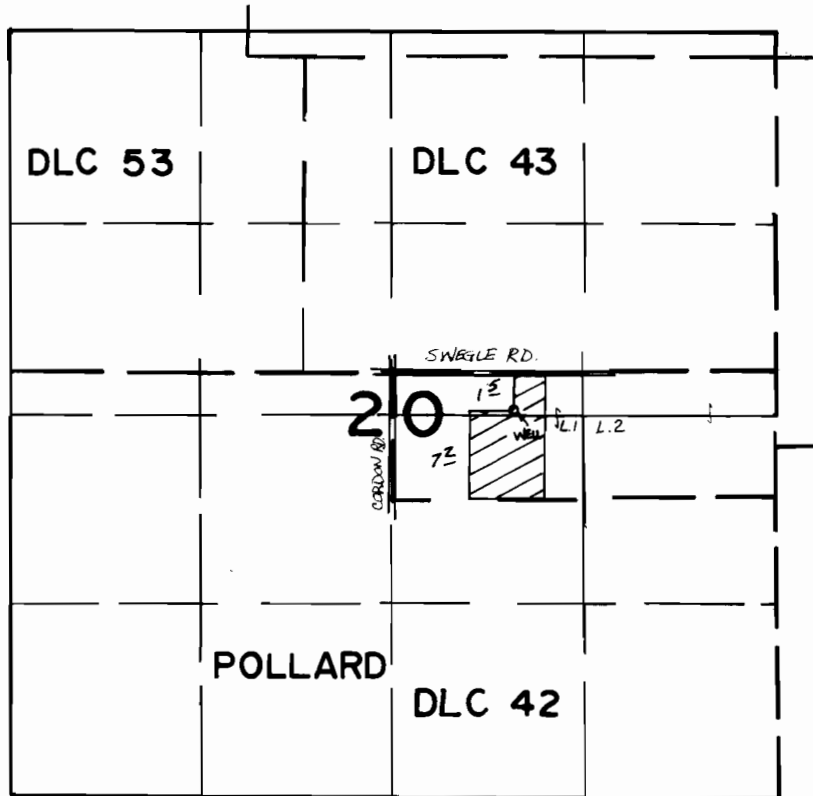

WELL LOCATION: 260' S. & 820' E.
FROM THE N'LY N.E. COR. DLC 42

FINAL PROOF SURVEY UNDER

Application No. G.9068 Permit No. G.8491.....
IN NAME OF

RICHARD T. MOSMAN.....

Surveyed NOV. 16, 1983, by M. CAHILL.....