


# T. 1 S., R. 2 E., W. M.

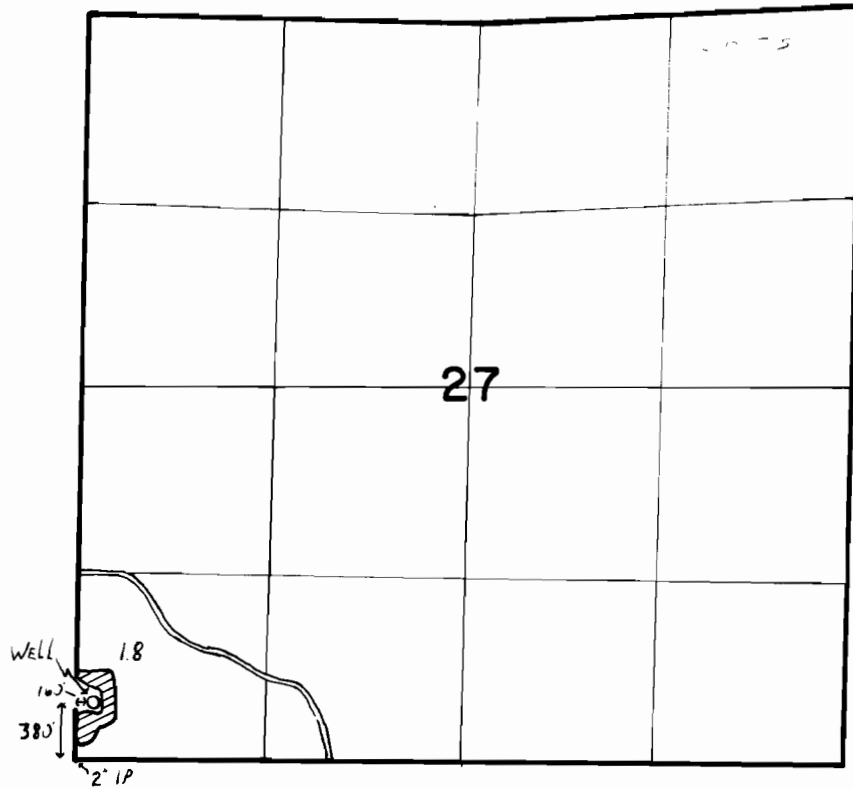

1" = 1320

## FINAL PROOF SURVEY UNDER

Application No. G 9298 Permit No. G 8637  
IN NAME OF

RICHARD J. BECK & LOIS R. BECK

Surveyed SEPT. 3 1987, by T. M. WARREN