
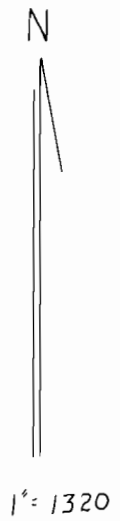


T.14S, R.4W., W.M.

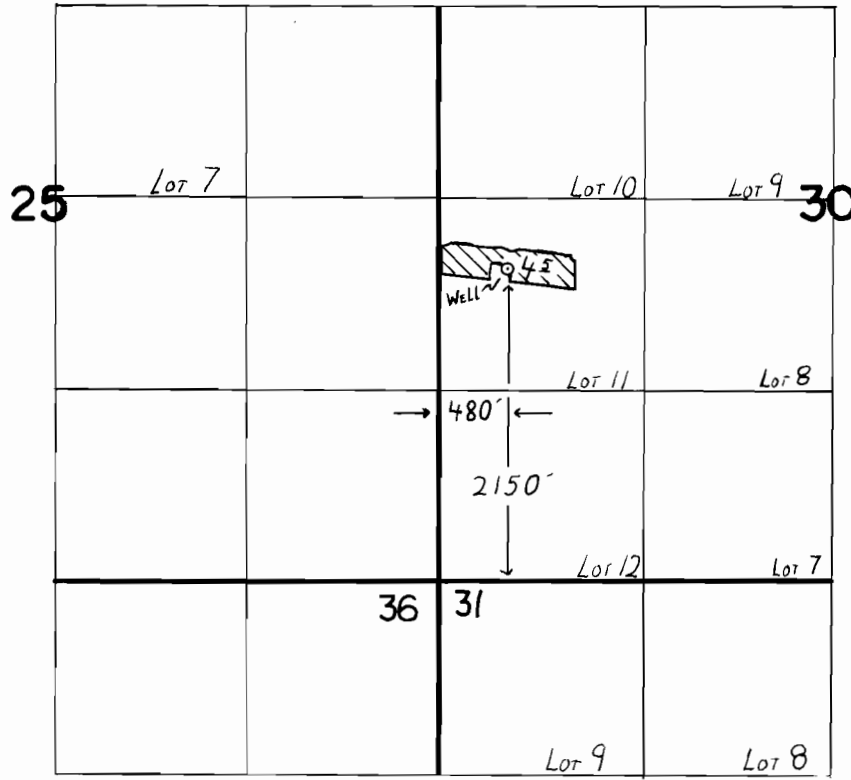

FINAL PROOF SURVEY UNDER

Application No. G.9530 Permit No. G8940
IN NAME OF

RANDALL D. CROWSON

Surveyed Nov. 25, 1987, by T.M. WARREN

RWK
DFJ-2LL-60