
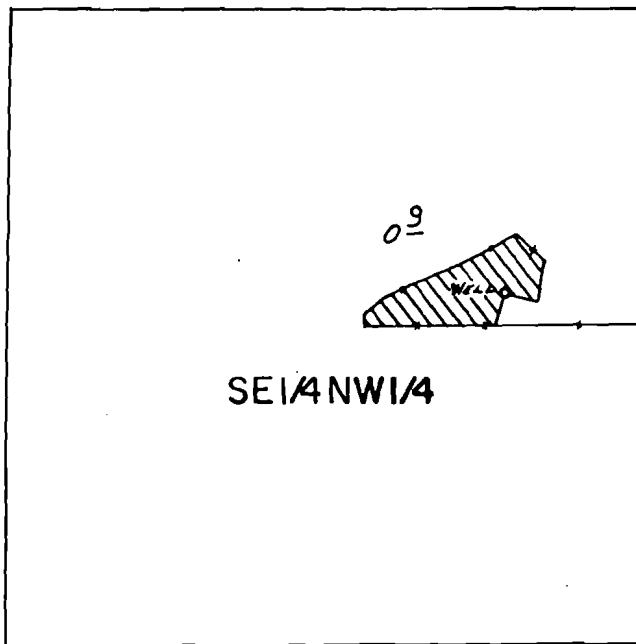


T.15S., R.12E., W.M.

SEC. 23

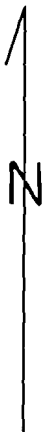

WELL LOC.: 725 N. of 280 W. FROM COR. 4th COR. SEC. 23

SCALE: 1" = 400'

FINAL PROOF SURVEY
UNDER

Application No. G-10076. Permit No. G-9428.....
IN NAME OF

Cert. 60056

.....ROYAL H. & LEILANI L. EDWARDS

Surveyed Oct. 26.... 19.88., by B.W. BISHOP.....

RECEIVED

DATE 4-5-89

WATER MASTER DISTRICT #11

BY *gms*

11/1/88
PTS 11-1988

G9428