


60 00057

RECEIVED RECEIVED

MAY 3 1983
WATER RESOURCES DEPT.
SALEM, OREGON

Sophia S. Henley
SE 1/4 of SE 1/4 Sec. 25

Application No. G-10896
Permit No. G10085

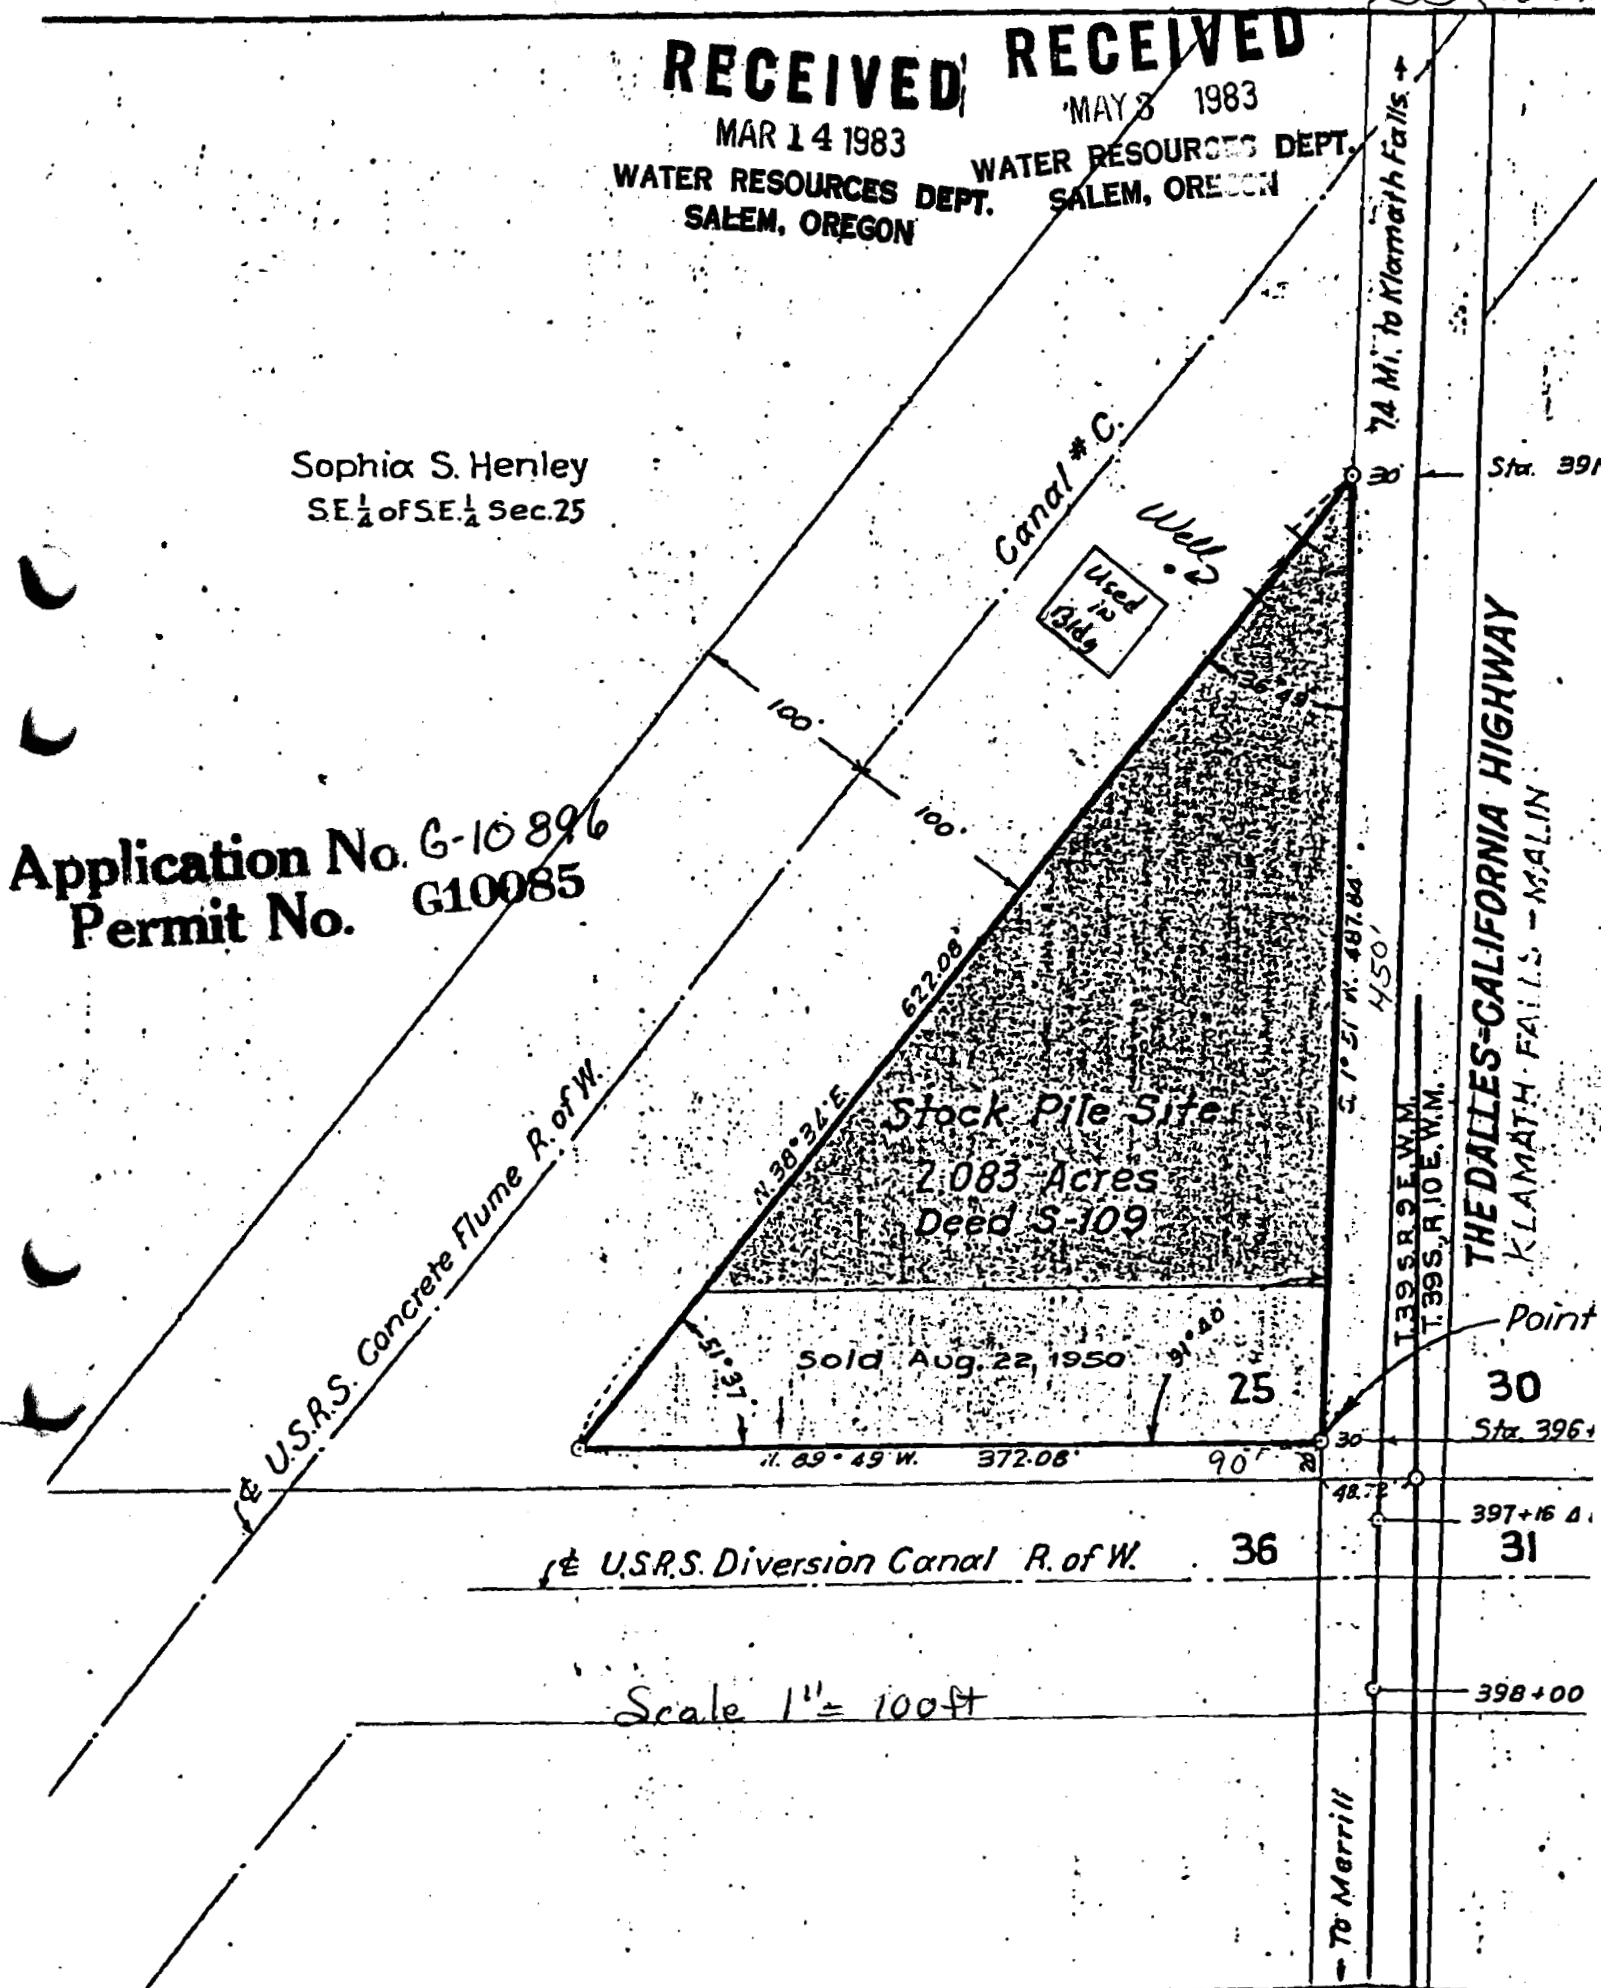

Scale 1" = 100ft

To Merrill