


T. 6S., R. 2E., W.M.

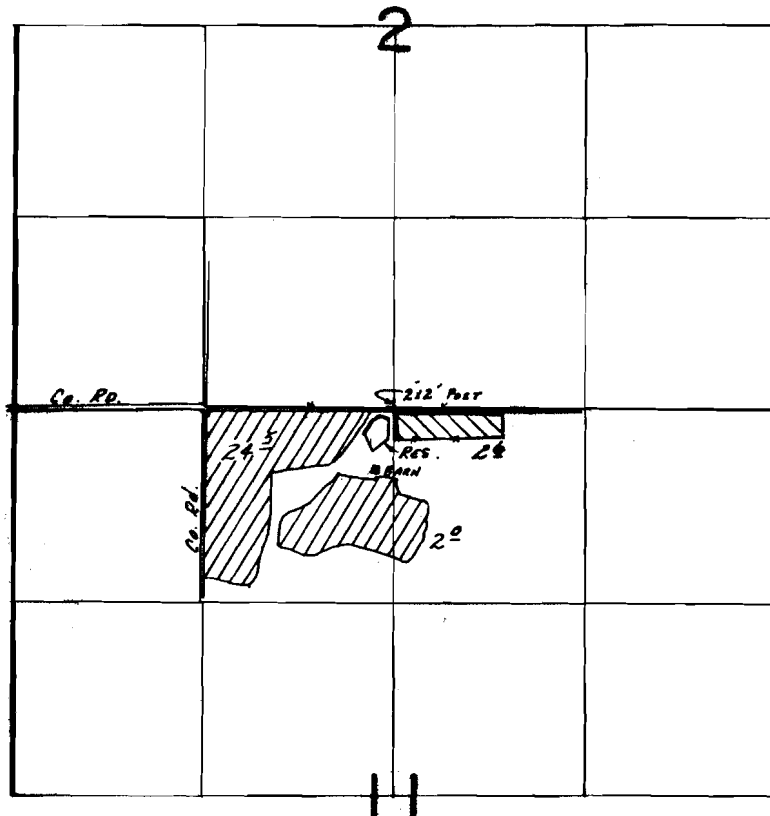

Dist. Pr. Loc.: 50 S. & 100 W. FROM N 1/4 COR. SEC. 11



Primary

Supplemental

SCALE: 1" = 1320'

FINAL PROOF SURVEY UNDER

R-56947 R-7599
Application No. ~~56948~~ Permit No. ~~43239~~.....
IN NAME OF

.....THOMAS P. STEINER.....

Surveyed July 25, 1984, by B.W. BISHOP.....
May 14 1985 T.M. WARREN