


T.3S., R.2W., W.M.

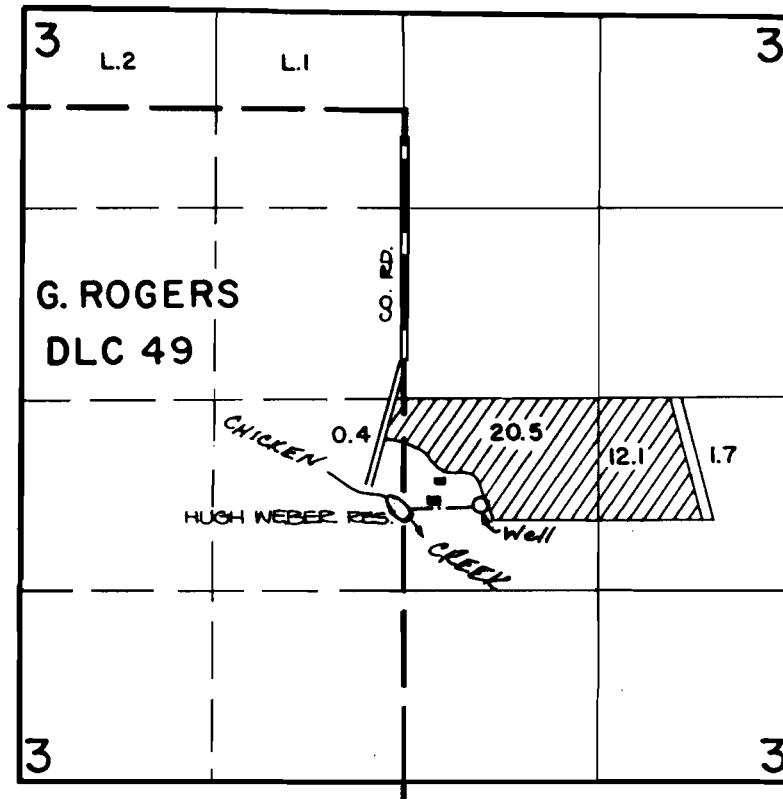

DIV. PT. LOCATION: 800 FT. S. AND 2680 FT. E. FROM THE
W. 1/4 CORNER OF SECTION 3. WELL LOCATION:
730 FEET S. AND 3150 FEET E. FROM THE
W. 1/4 CORNER SECTION 3.



SCALE: 4" = 1 MILE

FINAL PROOF SURVEY

UNDER

G-9773

G-9041

R-57530

R-7665

Application No. 57531 Permit No. 43290

IN NAME OF

HUGH WEBER

Surveyed NOV. 9, 1984, by P. P. P. P. P.
JULY 31, 1987 B. BISHOP