


# T. 8S., R. 5W., W.M.

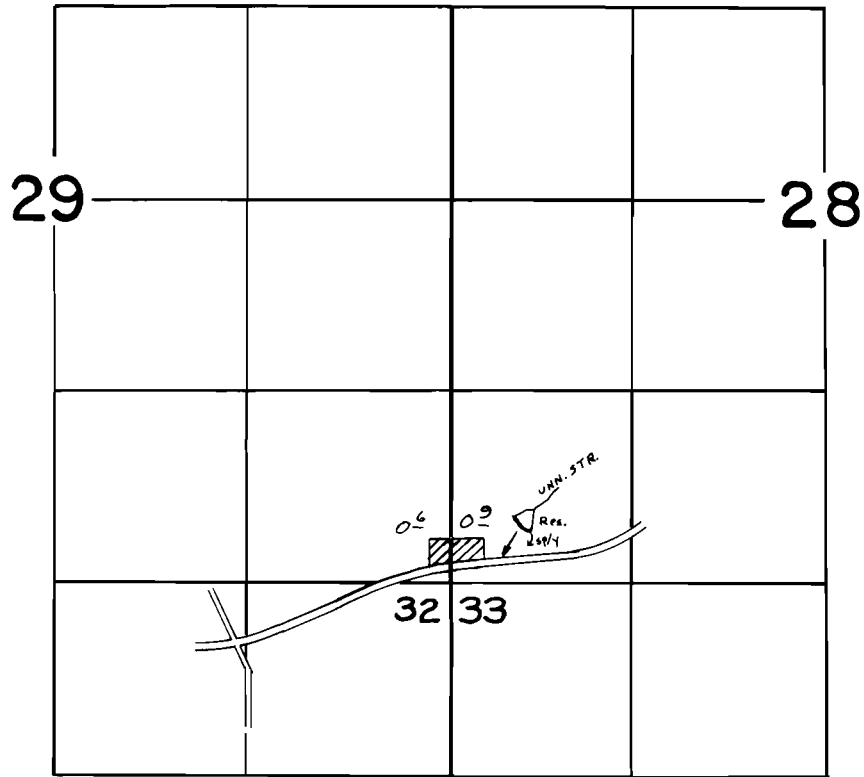

Dem. Loc.: 400' N. & 480' E. fr. S.W. cor. sec. 28

SCALE: 1" = 1320'

## FINAL PROOF SURVEY UNDER

57283                      43300  
Application No. R-57282    Permit No. R-7668  
IN NAME OF

**ROD DABERKOW**

Surveyed AUG 11 1983, by L. TOLL