


T. 8S., R. 5W., W.M.

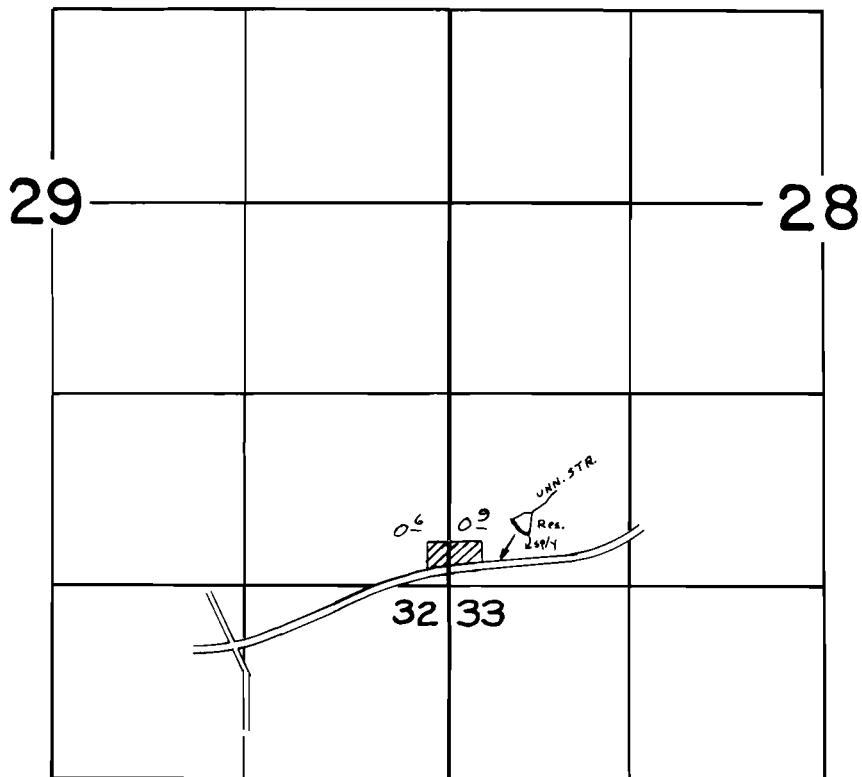

Dem. Loc.: 400' N. & 480' E. fr. S.W. cor. sec. 28

SCALE: 1" = 1320'

FINAL PROOF SURVEY UNDER

57283 43300
Application No. R-57282 Permit No. R-7668
IN NAME OF

ROD DABERKOW

Surveyed AUG 11 1983, by L. TOLL